


T. 29S. R. 12W. W.M.

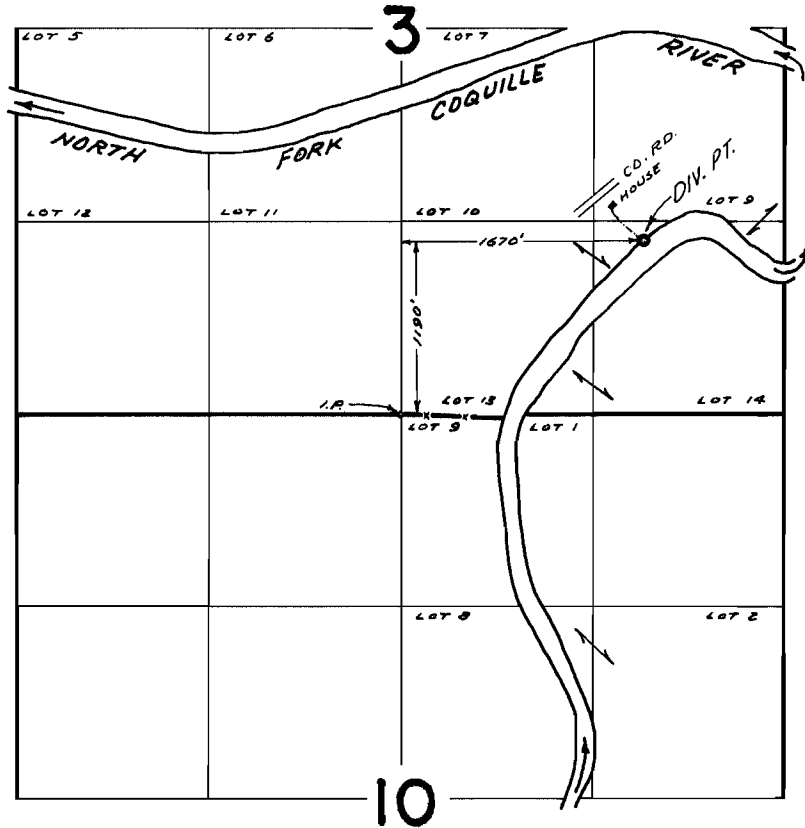

FINAL PROOF SURVEY
UNDER

Application No. 39605 Permit No. 29433
IN NAME OF

CLYDE R. GRASTY

Surveyed AUG. 20 1969, by D. BUELL