


T. 28 S. R. 12 W. W. M.

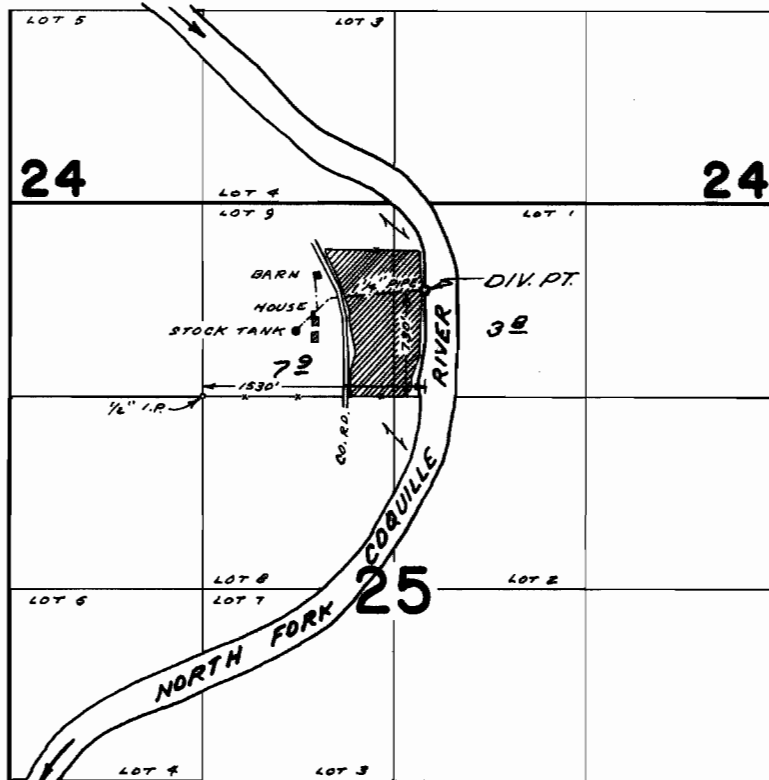

FINAL PROOF SURVEY UNDER

Application No. 39615 Permit No. 29937
IN NAME OF

FRITZIE SCHLIEMANN

Surveyed AUG. 27 1969, by D. BUELL