


T. 30 S. R. 11 W. W. M.

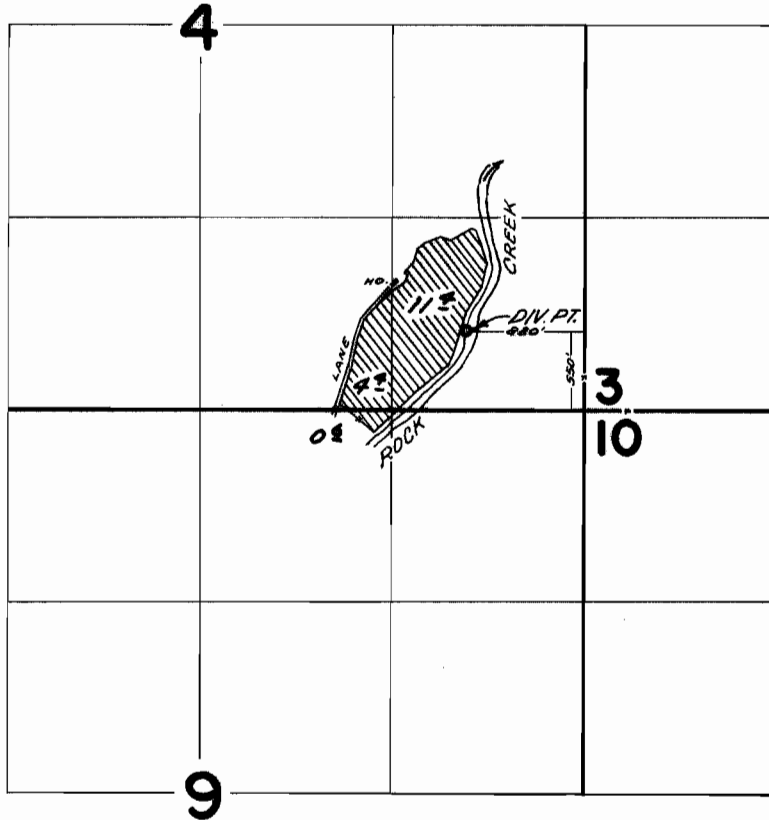

FINAL PROOF SURVEY
UNDER

Application No. 39659 Permit No. 29464
IN NAME OF

H. GAIL SMITH

Surveyed SEP. 9 1969, by D. BUELL