


T. 30 S. R. 11 W. W. M.

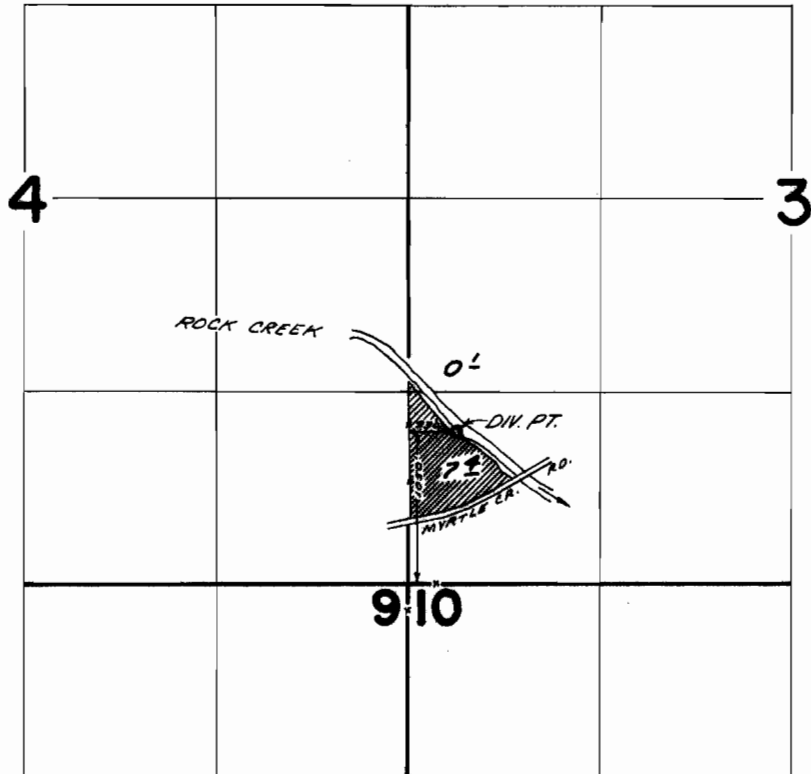

**FINAL PROOF SURVEY**  
UNDER

Application No. 39666 Permit No. 29467  
IN NAME OF

HARVEY C. ARGO

Surveyed SEP. 9 1969, by D. BUELL