


T. 30 S. R. 11 W. W. M.

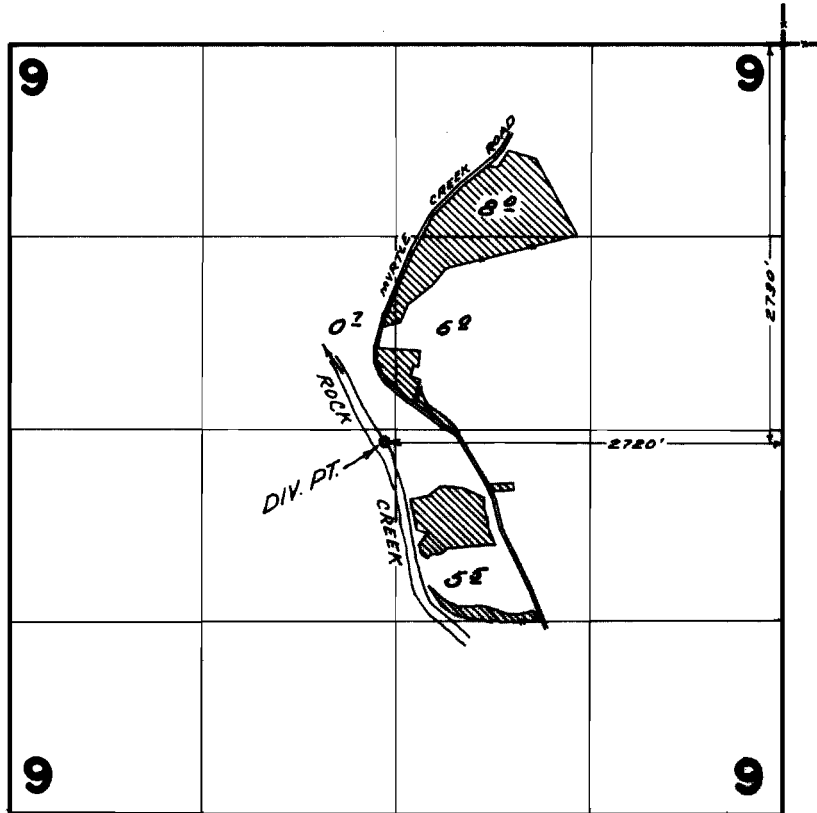

FINAL PROOF SURVEY UNDER

Application No. 41353 Permit No. 30890
IN NAME OF

EARNEST E. SELL

Surveyed SEP. 10 1969, by D. BUELL