


T. 31 S. R. 15 W. W.M.

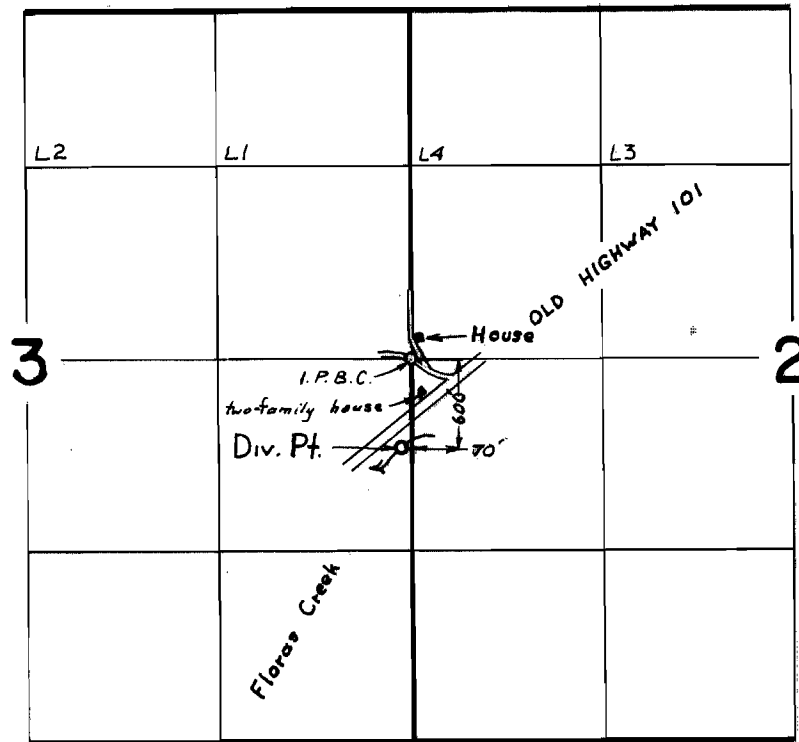

FINAL PROOF SURVEY UNDER

Application No. 39798 Permit No. 29583
IN NAME OF

H. H. & DORIS HANSEN

Surveyed May 16 1969, by L. E. Gould