


T. 39 S. R. 14 W. W. M.

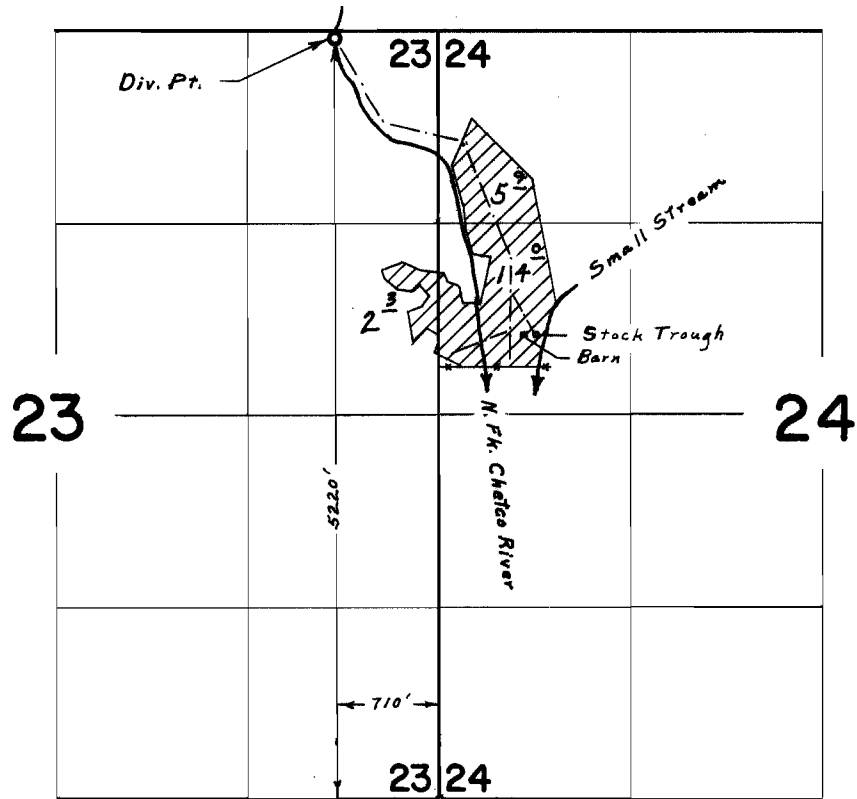

FINAL PROOF SURVEY
UNDER

Application No. 39773. Permit No. 29639.
IN NAME OF

STANLEY COLEGROVE

Surveyed Sept. 15, 1969, by L. E. Gould