


# T. 32 S. R. 4 & 5 W. W.M.

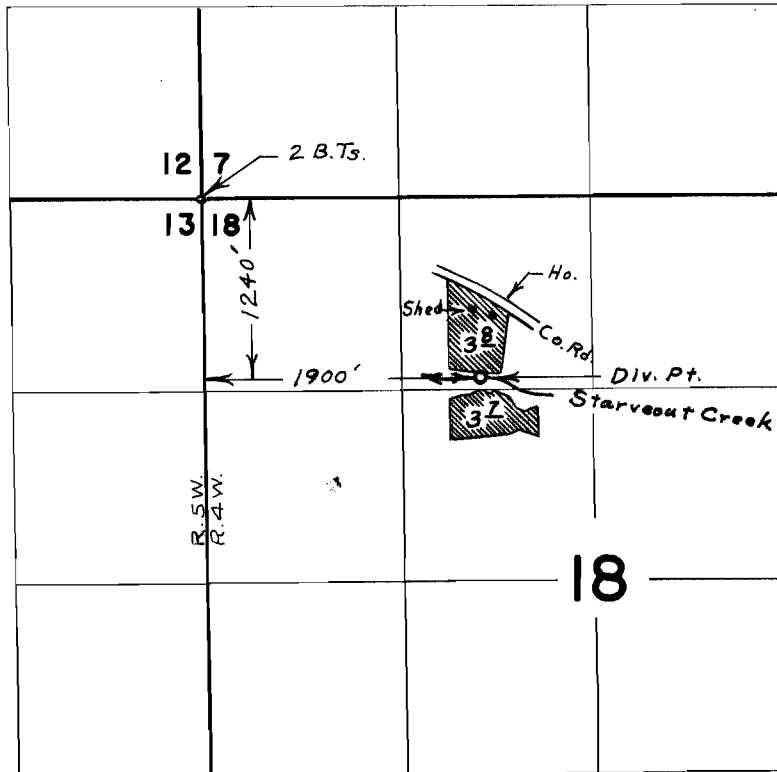

## FINAL PROOF SURVEY UNDER

Application No. 39075 Permit No. 29096  
IN NAME OF

RICHARD OLIVER WEISCHEDEL

Surveyed April 28, 1969, by L. E. Gould