


# T. 26 S. R. 6 W. W.M.

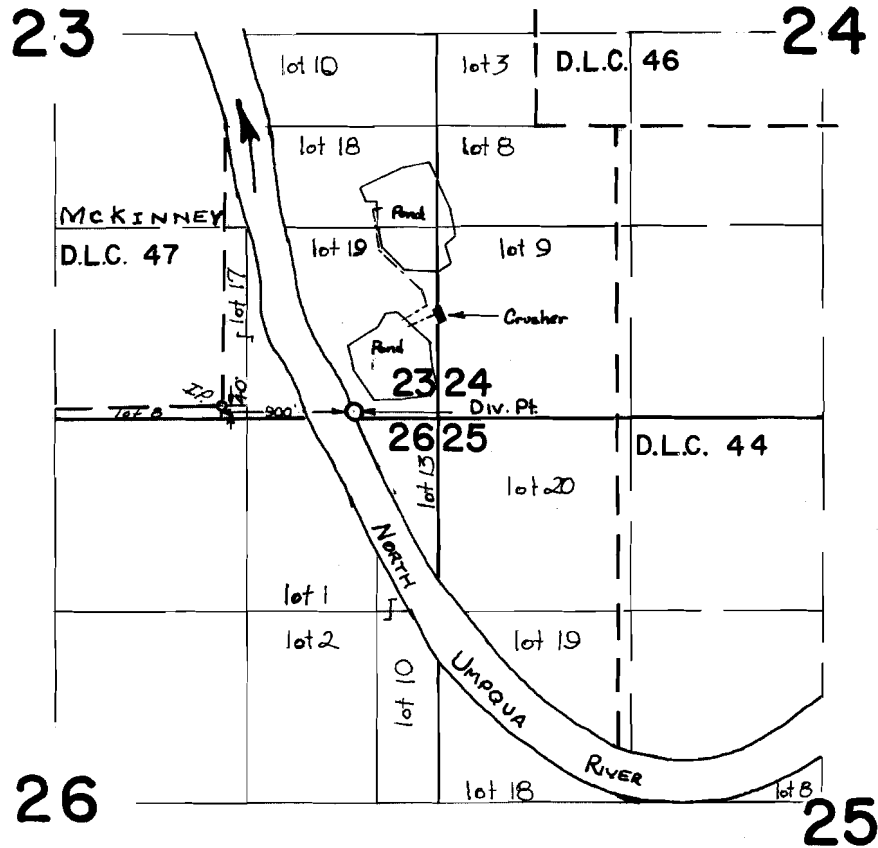

## FINAL PROOF SURVEY UNDER

Application No. 40102... Permit No. 29682...  
IN NAME OF

ROY L. HOUCK SONS' CORP.

Surveyed 8 SEPT. 1969, by W. J. RUPPERT.