


T. 29 S. R. 6 W. W.M.

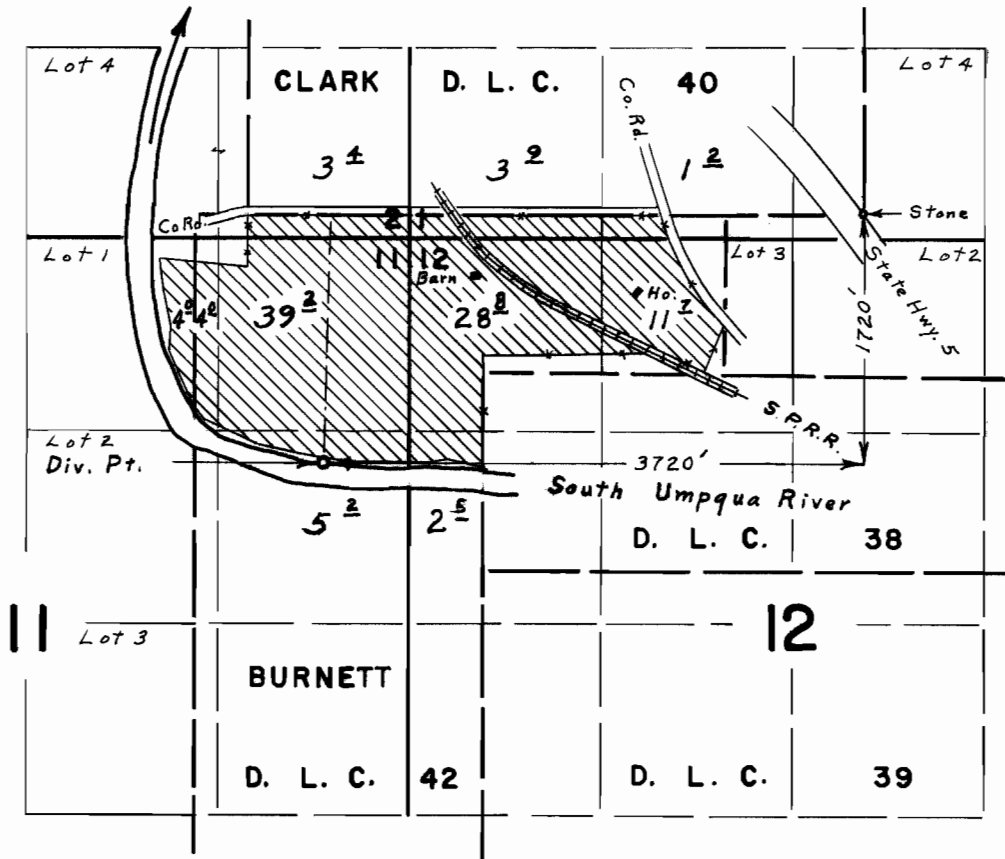

FINAL PROOF SURVEY UNDER

Application No. 40032 Permit No. 29973
 IN NAME OF
JACK ANDERSON

Surveyed Aug. 6, 1969, by L. E. Gould