


T. 29 S. R. 6 W. W.M.

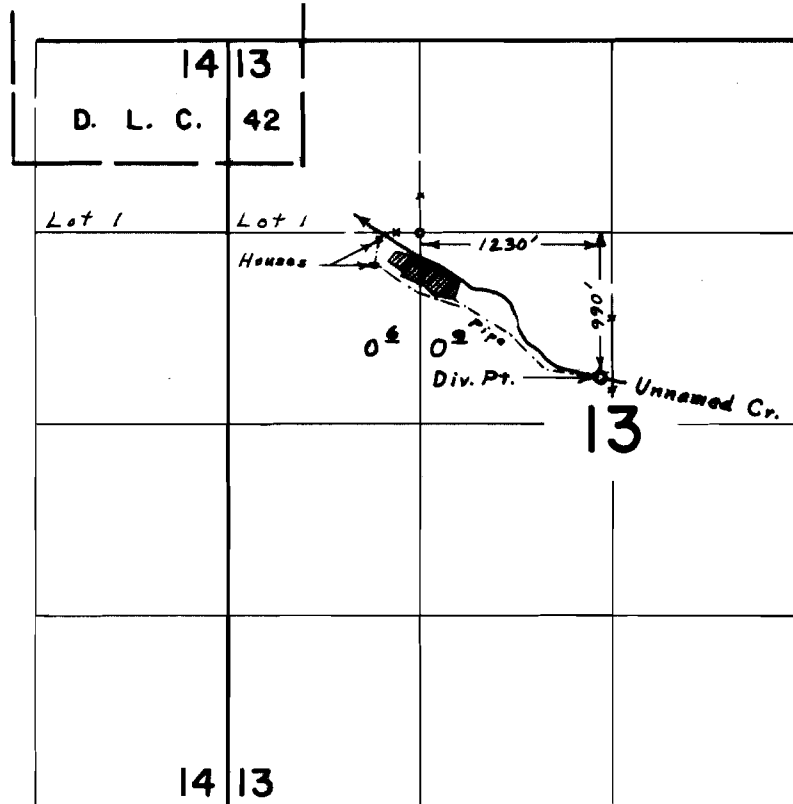

FINAL PROOF SURVEY
UNDER

Application No. 40852.. Permit No. 30455..
IN NAME OF

KENNETH & KEATH RONK

Surveyed Aug. 5., 1969, by L. E. Gould