


T. 32 & 33 S. R. 7 W. W.M.

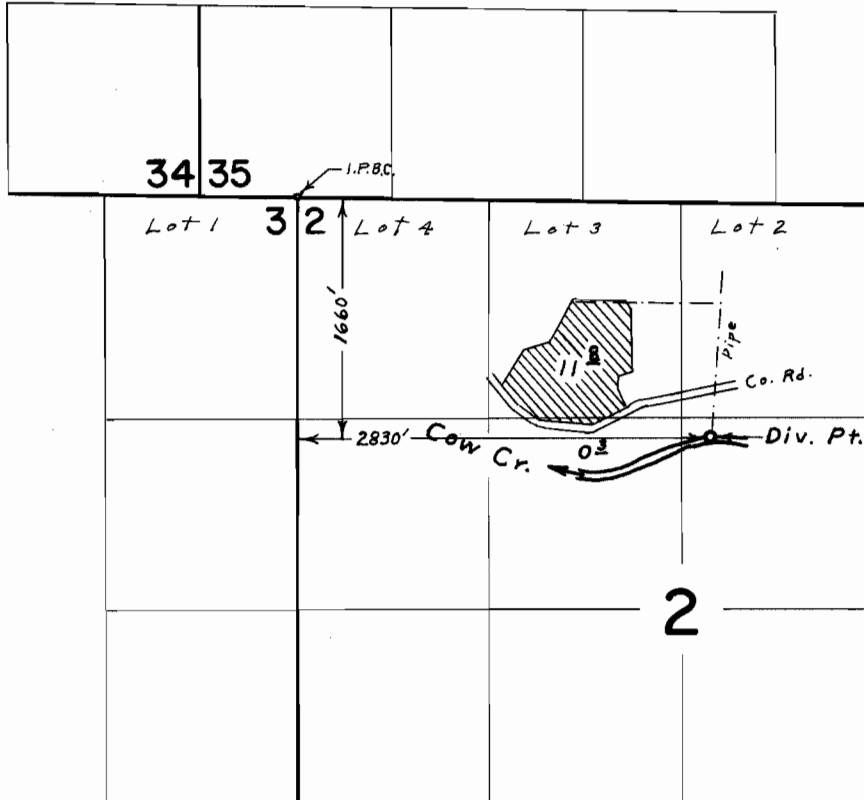

FINAL PROOF SURVEY
UNDER

Application No. 41103 Permit No. 30510
IN NAME OF

FRANK L. HORCAJO

Surveyed May 1, 1969, by L. E. Gould