


T.27S.R.4W.W.M.

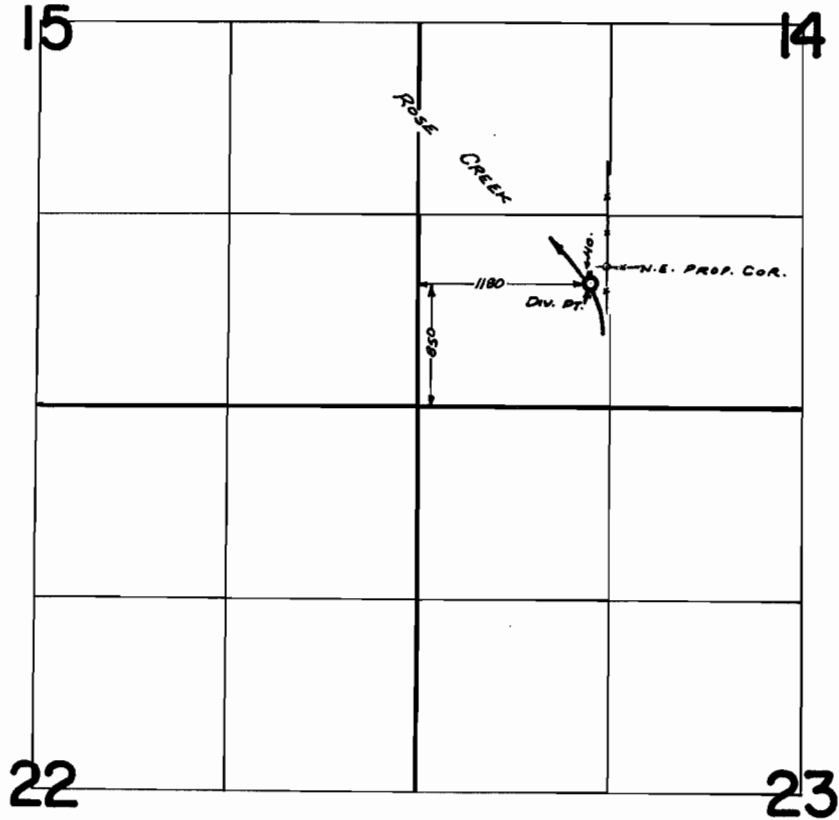

FINAL PROOF SURVEY
UNDER

Application No. 42306..... Permit No. 31787.....
IN NAME OF

MR. & MRS. LeNOIR KRUSE

Surveyed APR. 16, 19.69, by W. RUPPERT