


T. 30 S. R. 4 W. W.M.

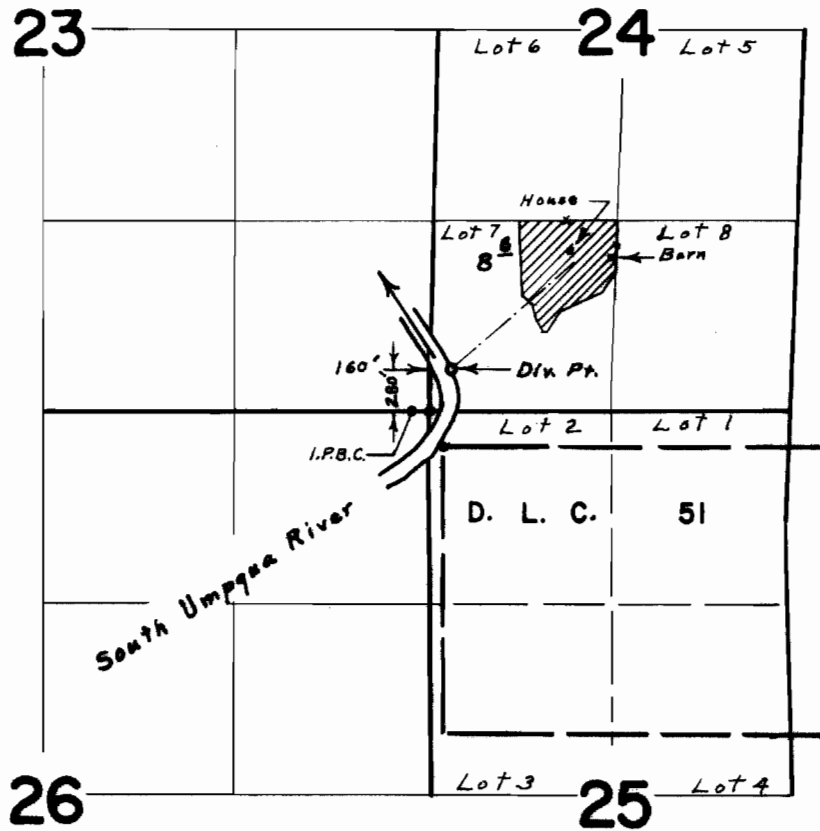

FINAL PROOF SURVEY
UNDER

Application No. 42757... Permit No. 31971...
IN NAME OF

JOHN E. & FLORENCE OTT

Surveyed June 26, 1969, by L. E. Gould