


T. 30 S. R. 4 W. W.M.

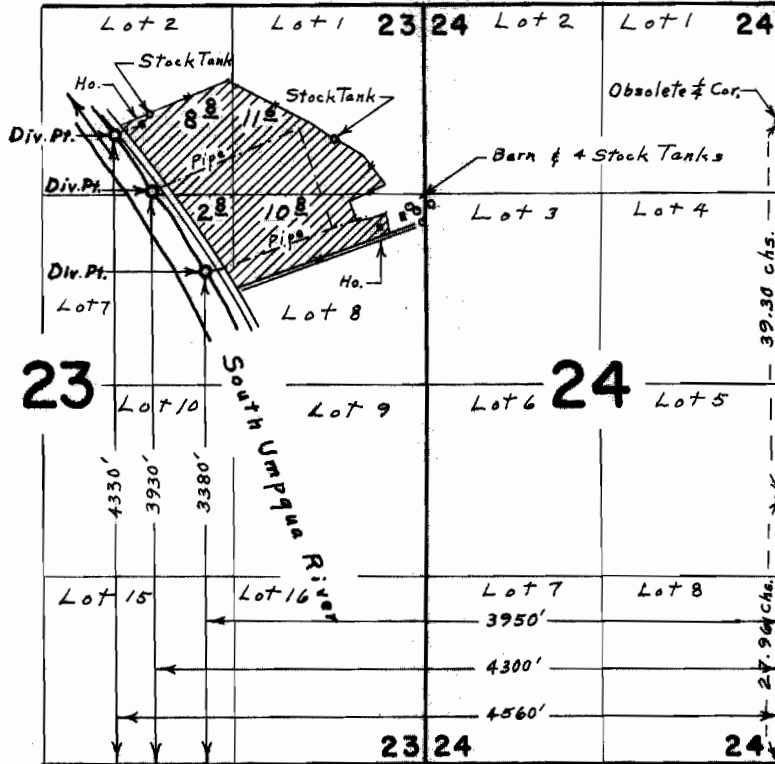

FINAL PROOF SURVEY UNDER

Application No. 43772 Permit No. 32710
IN NAME OF

DONALD B. MILLER

Surveyed July 31, 1969, by L. E. Gould