


T. 29 S. R. 6 W. W. M

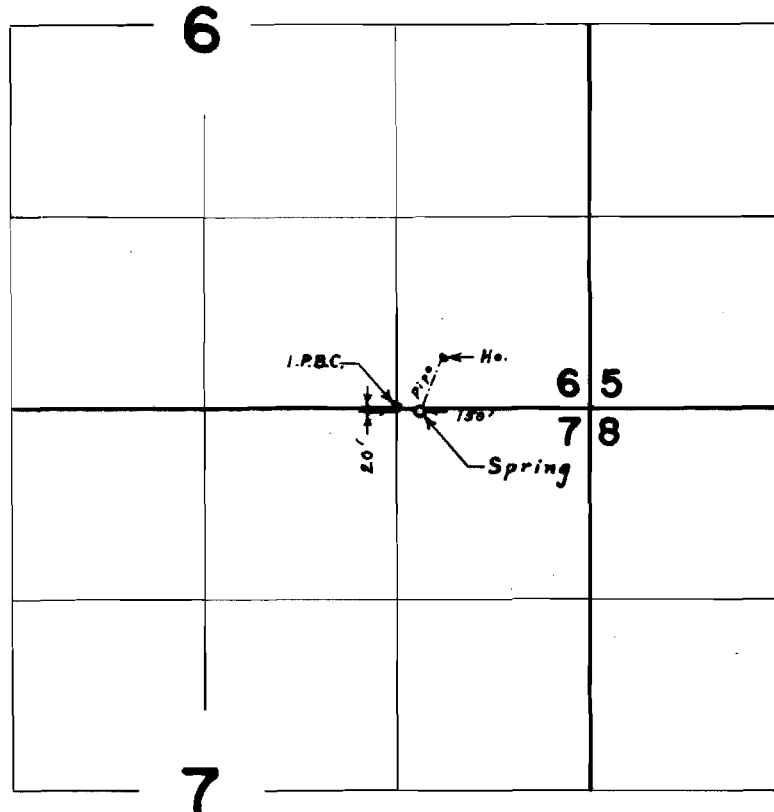

FINAL PROOF SURVEY
UNDER

Application No. 44116 Permit No. 32953
IN NAME OF

RAY G. McALPINE

Surveyed Aug. 5, 1969, by L. E. Gould