


T.26S.R.4W.W.M.

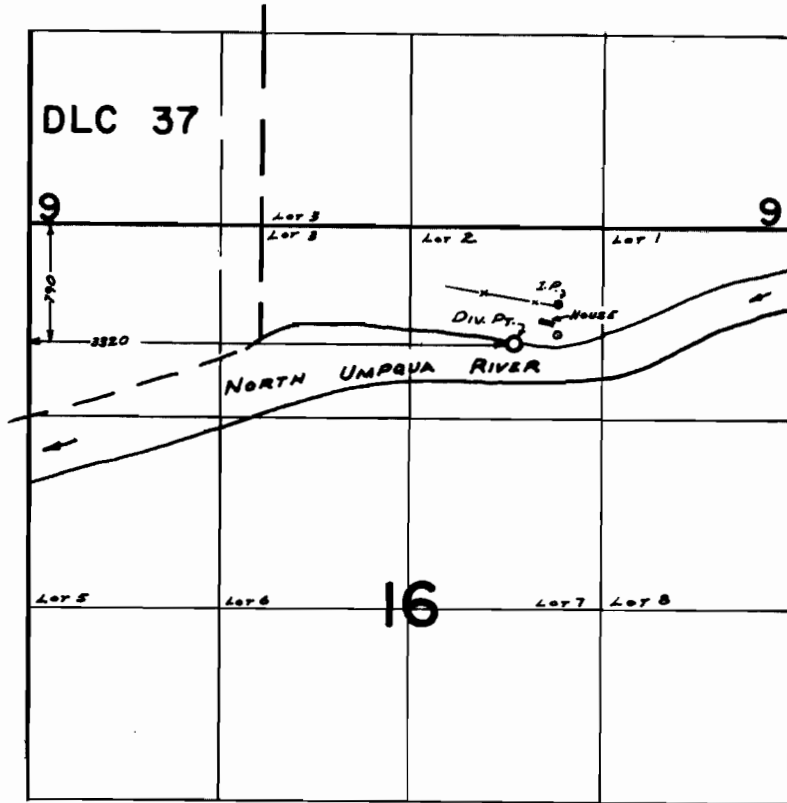

FINAL PROOF SURVEY
UNDER

Application No. 44225..... Permit No. 33034.....
IN NAME OF

MARY JONES

Surveyed APR. 18, 19.69, by W. RUPPERT.