


T. 29 S. R. 6 W. W.M. .

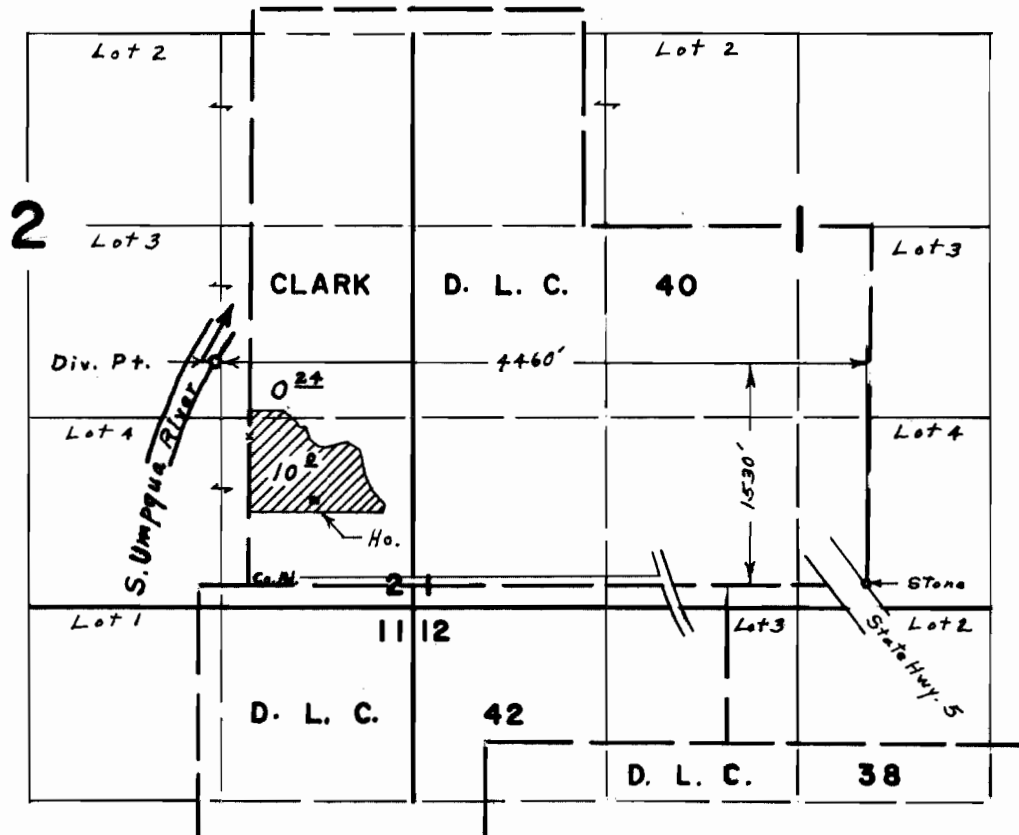

FINAL PROOF SURVEY UNDER

Application No. 45321 Permit No. 33832
 IN NAME OF
ARTHUR C. & ELAINE F. DRUMRIGHT

Surveyed Aug. 6, 1969, by L. E. Gould