
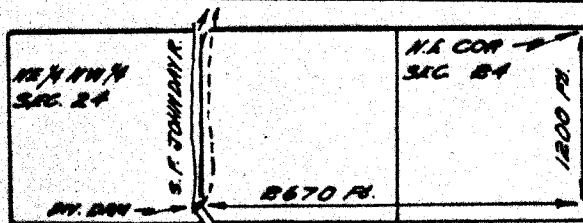


28272  
37205

# T.13S. R.26E.W.M.

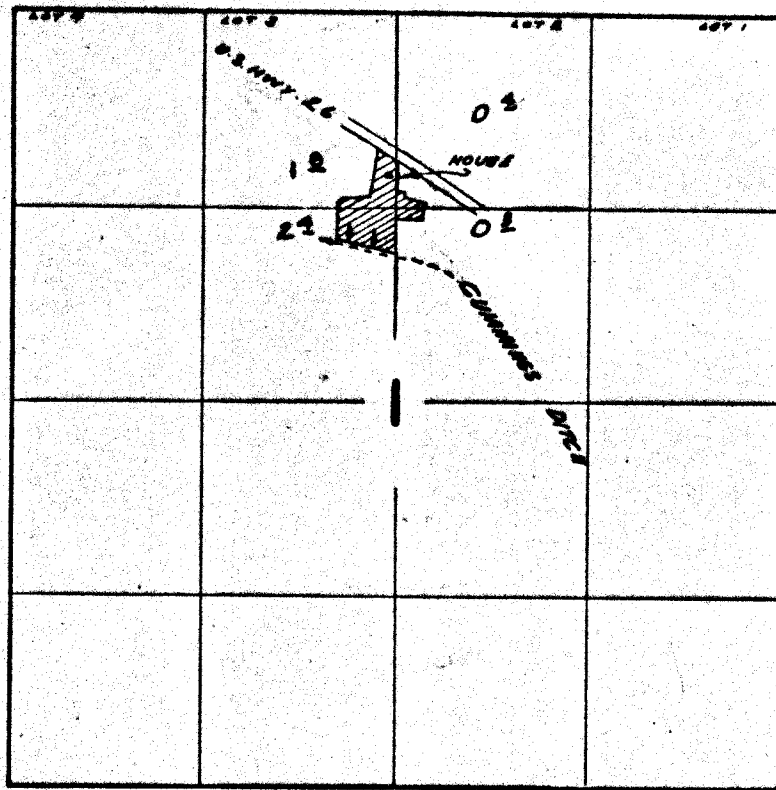

DIVERSION POINT  
LOCATION TAKEN  
FROM ADJUDICATION  
MAP

*DIV PT. shown at  
WRONG LOCATION  
FOR SUMMERS  
DITCH*

## FINAL PROOF SURVEY UNDER

Application No. 37677. Permit No. 28272.

IN NAME OF

**WAYNE E. & PEGGY J. ADAMS**

Surveyed May 18, 1968, by *W. d. Ruppert*