
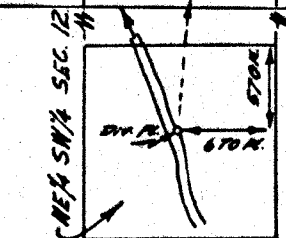



29264  
37206

# T.14S.R.34E.W.M.

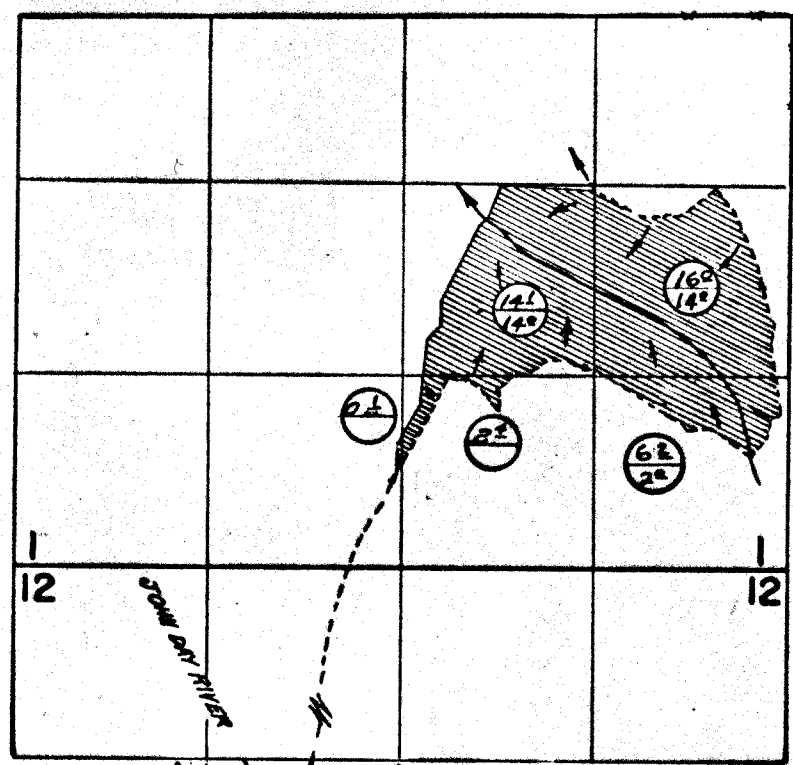


 Permit 29264  
 Cont. 10001

see permit  
35892

## FINAL PROOF SURVEY UNDER

Application No. 39295 Permit No. 29264  
 IN NAME OF  
**WAYNE E. & KATHERINE M. DEXTER**

Surveyed July 18, 1968, by *R. D. Pappert*