


31279
37208

T.35S.R.12-13E.W.M.

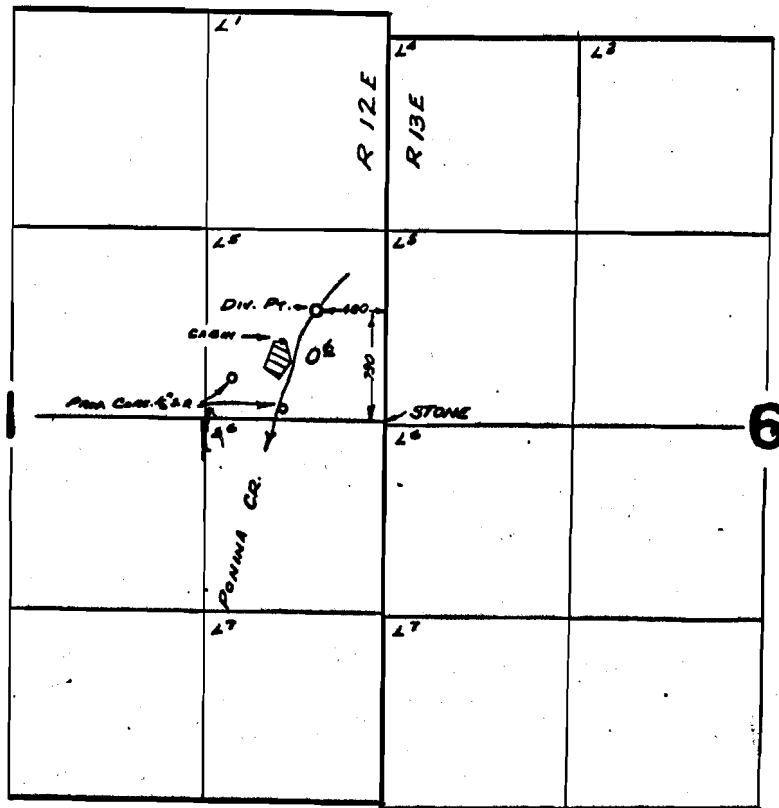

FINAL PROOF SURVEY
UNDER

Application No. 41727..... Permit No. 31279.....
IN NAME OF

A. C. YADEN

Surveyed MAY 14, 1970, by R. MUCKEN