


T.38S. R.20E. W.M.

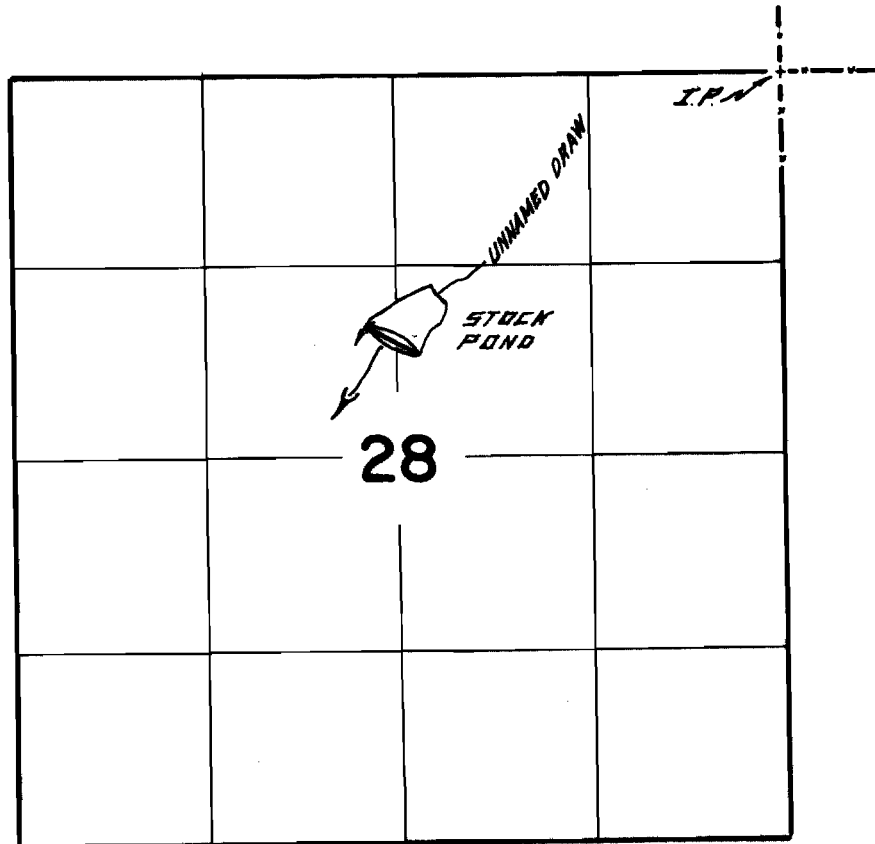

FINAL PROOF SURVEY
UNDER

Application No. *T-41223* Permit No. *T-4524*
IN NAME OF

WILLIAM PERANG

Surveyed *August 8* 1968, by *H. d. Rygaard*