


# T. 16 S. R. 3 W. W.M.

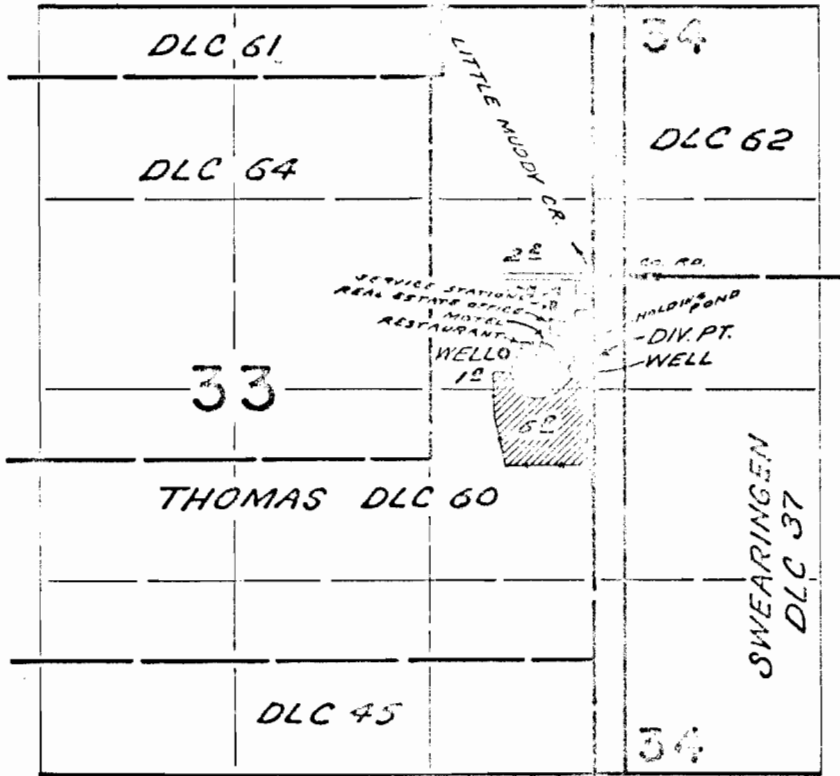

WELLS LOCATED; 540' S. & 610' W.; 650' S. & 130' W.  
 DIV. PT. LOCATED 580' S. & 30' W  
 ALL FROM NW COR SWEARINGEN DLC 64

 CREEK ONLY  WELLS & CREEK

## FINAL PROOF SURVEY UNDER

Application No. 6-2773 37833 Permit No. 6-2615 28696  
 IN NAME OF

VIRMA CORPORATION

Surveyed APR. 30 1969, by O. BUELL