


T. 16 S. R. 3 W. W. M.

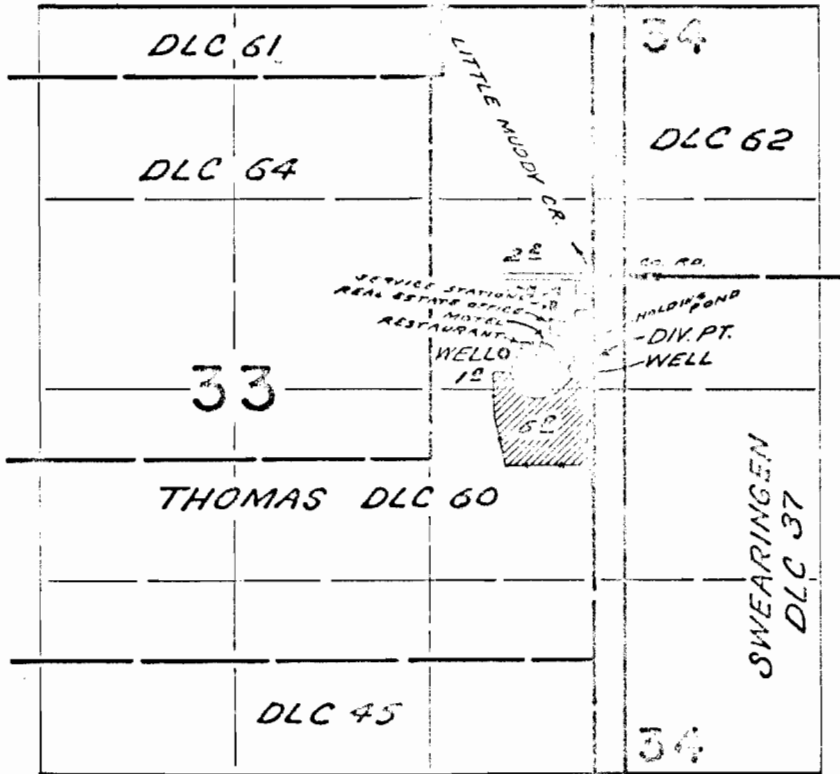

WELLS LOCATED; 540' S. & 610' W.; 650' S. & 130' W.
 DIV. PT. LOCATED 580' S. & 30' W
 ALL FROM NW COR SWEARINGEN DLC 64



CREEK ONLY



WELLS & CREEK

FINAL PROOF SURVEY
 UNDER

Application No. 6-2773 37833 Permit No. 6-2615 28696
 IN NAME OF

VIRA CORPORATION

Surveyed APR. 30 1969, by O. BUELL