


T. 16 S. R. 3 W. W. M.

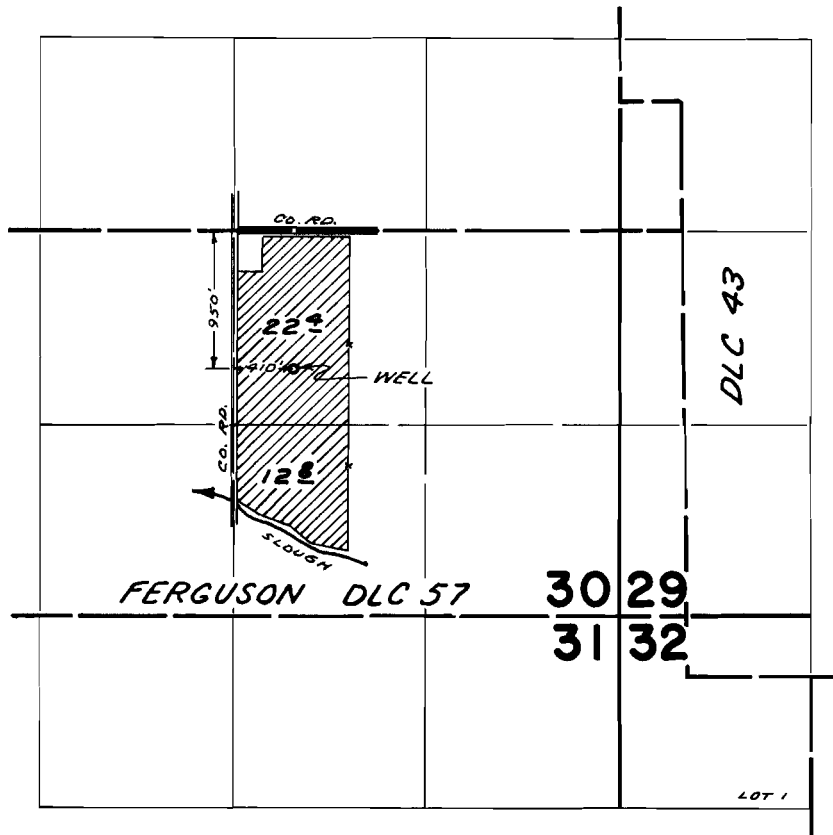

FINAL PROOF SURVEY UNDER

Application No. G-2995 Permit No. G-2792
IN NAME OF

HARRY E. HARBERT

Surveyed APR. 29 1969, by D. BUELL