


T. 16 S. R. 4 W. W. M.

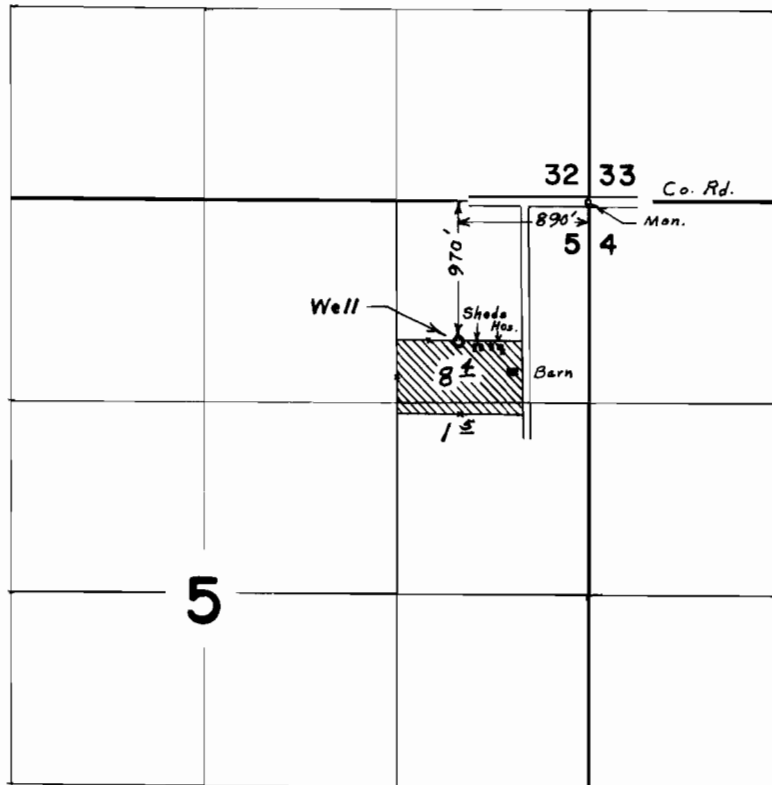

**FINAL PROOF SURVEY**  
UNDER

Application No. G-3166 Permit No. G-2979  
IN NAME OF

**METHA ROGERS**

Surveyed April 21, 1969, by L. E. Gould