


T. 16 S. R. 4 W. W.M.

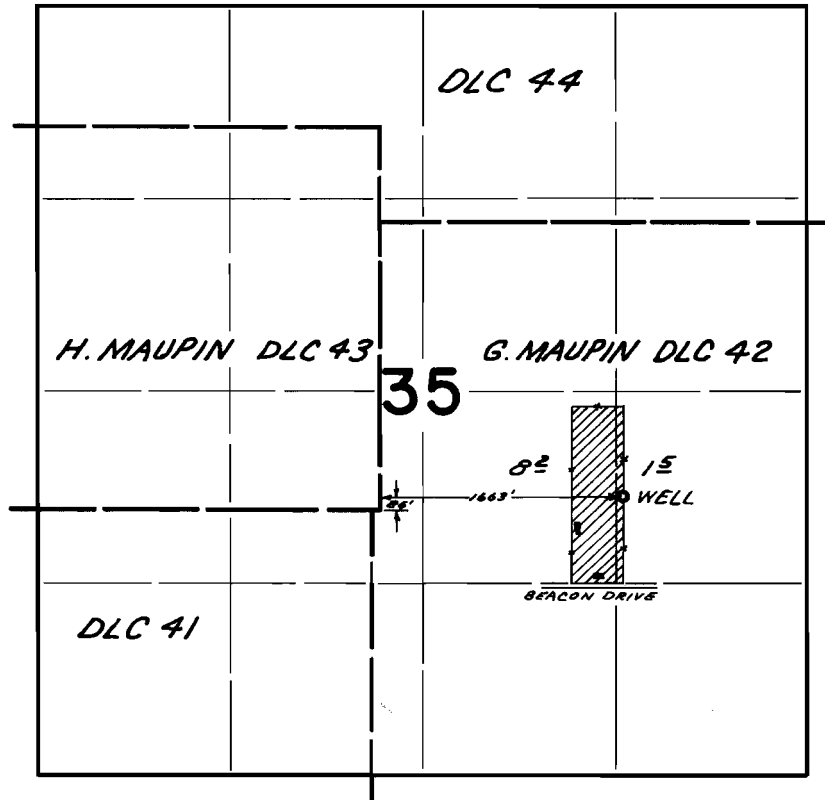

FINAL PROOF SURVEY
UNDER

Application No. G-4543 Permit No. G-3942
IN NAME OF

JUSTIN W. BRABHAM

Surveyed MAY 28 1969, by D. BUELL