


T. 16 S. R. 4 W. W. M.

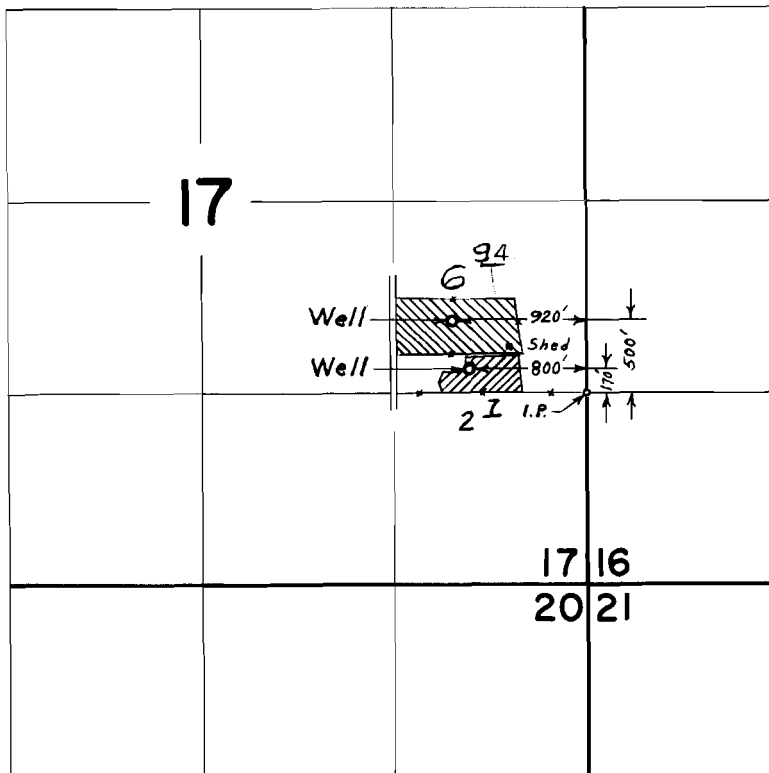

FINAL PROOF SURVEY
UNDER

Application No. G-4522 Permit No. G-4260 
G-4523 G-4261 
IN NAME OF

WARREN L. AVERILL

Surveyed April 23, 1969, by L. E. Gould