


T. 18 S. R. 11 W. W.M.

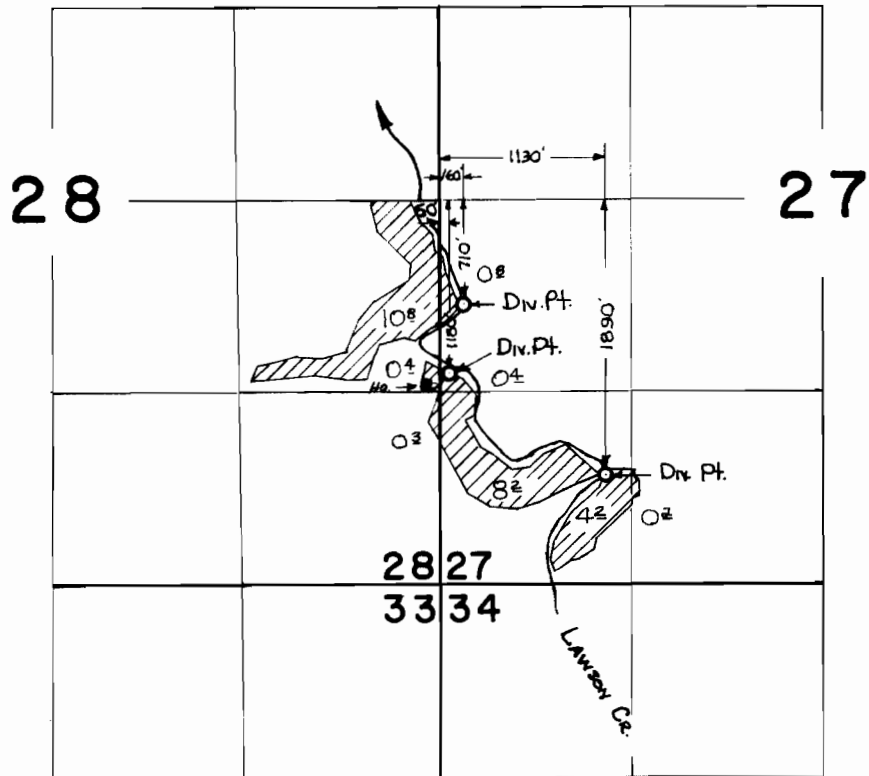

**FINAL PROOF SURVEY**  
UNDER

Application No. 37483... Permit No. 27904...  
IN NAME OF

**RALPH BERNHARDT & SONS**

Surveyed 7 AUG . 1969, by W. J. RUPPERT.