


T. 17 S. R. 11 W. W. M.

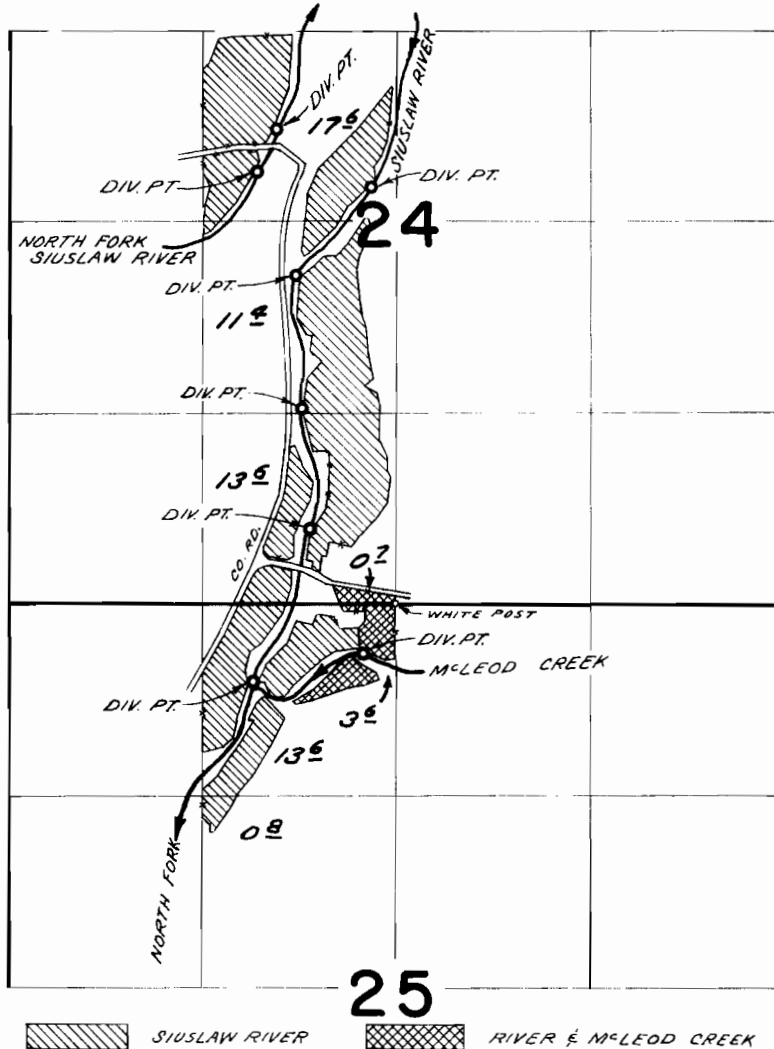

DIV. PTS. LOCATED: N. FK. SIUSLAW R., 3270' N. & 820' W.; 2970' N. & 950' W.; 2870' N. & 170' W.; 2260' N. & 690' W.; 1350' N. & 650' W.; 520' N. & 590' W.; 540' S. & 980' W.; M^cLEOD CR., 340' S. & 220' W.;
 ALL FROM N. 1/4 COR. SEC. 25

FINAL PROOF SURVEY UNDER

Application No. *38158* Permit No. *28445*
 IN NAME OF

W. J. AND VERN MEADOWS

Surveyed *AUG. 5 1969*, by *D. BUELL*