


T.17 S.R.10 W. W.M.

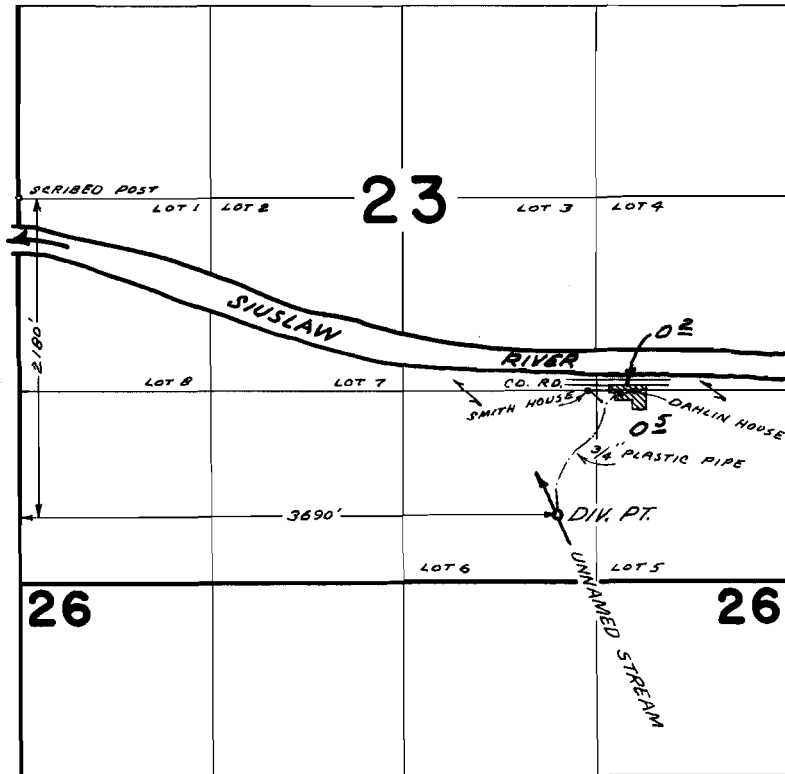

FINAL PROOF SURVEY UNDER

Application No. 39885 Permit No. 29694

IN NAME OF
**LAWRENCE E. DAHLIN AND
KENNETH C. SMITH**

Surveyed AUG 7 1969, by D. BUELL