


T.17S.R.10W.W.M.

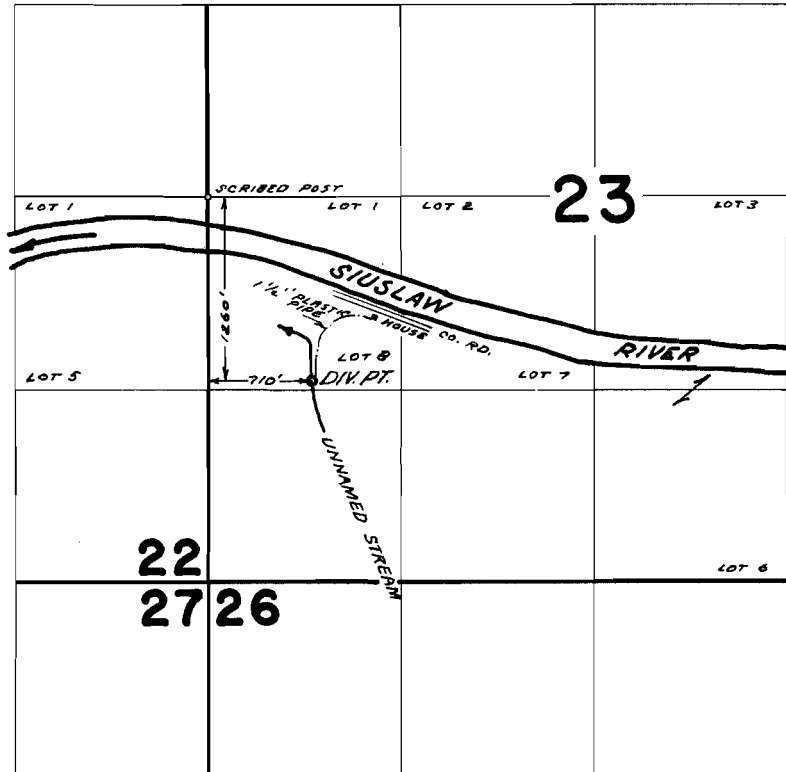

FINAL PROOF SURVEY UNDER

Application No. 39945 Permit No. 29730
IN NAME OF

HENRY WHITTALL

Surveyed AUG. 7 1969, by D. BUELL