


T.17 S.R.10W. W.M.

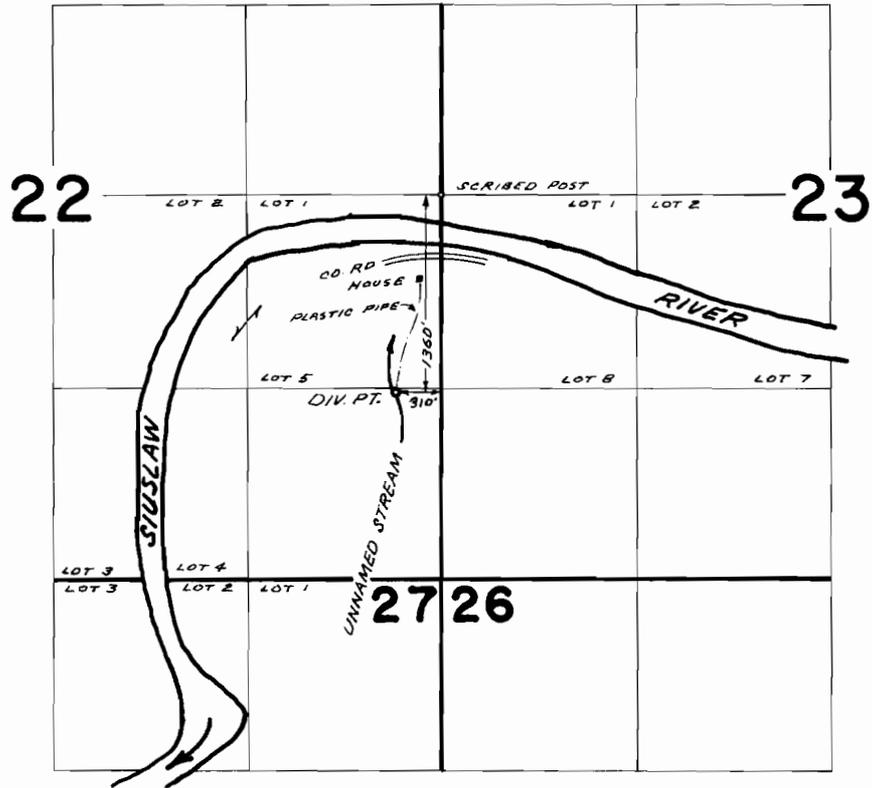

FINAL PROOF SURVEY UNDER

Application No. 42916 Permit No. 32066
IN NAME OF

GEORGE CRABBE

Surveyed AUG. 7, 1969, by D. BUELL