


T.17S.R.10W.W.M.

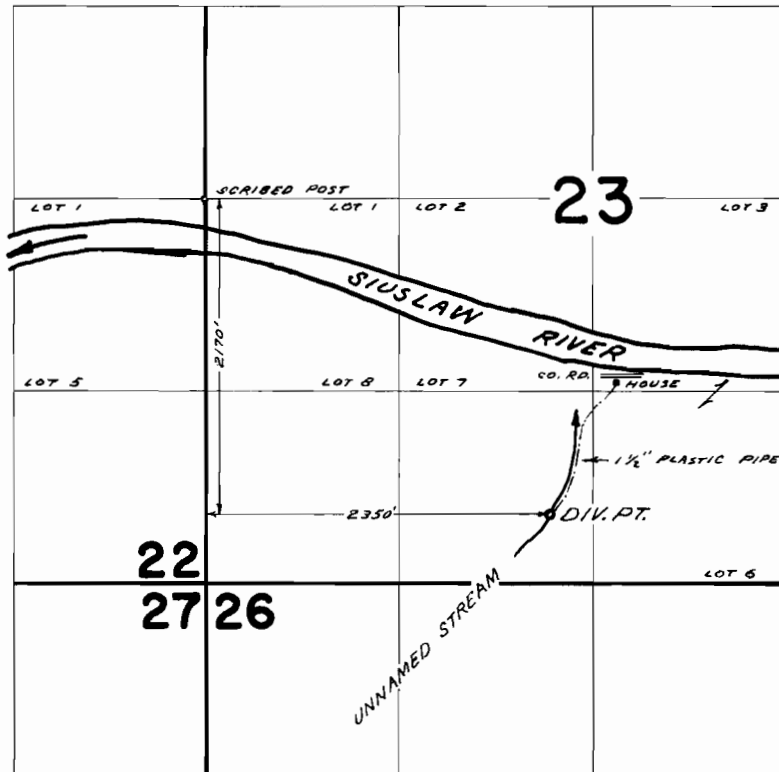

FINAL PROOF SURVEY UNDER

Application No. 42940 Permit No. 32083
IN NAME OF

DELBERT LAMM

Surveyed AUG 7 1969, by D. BUELL