


T.17S.R.2W.W.M.

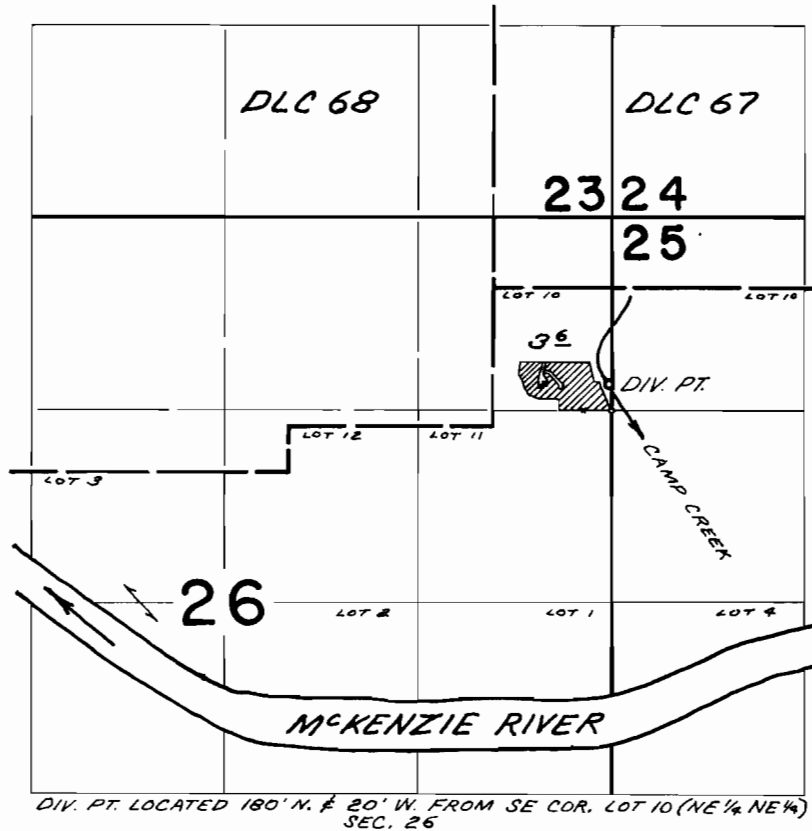

FINAL PROOF SURVEY
UNDER

Application No. 43/20 Permit No. 32219
IN NAME OF

WILLIAM L. McCULLOCH

Surveyed MAY 29 1969, by D. BUELL