


T.17S.R.2W.W.M.

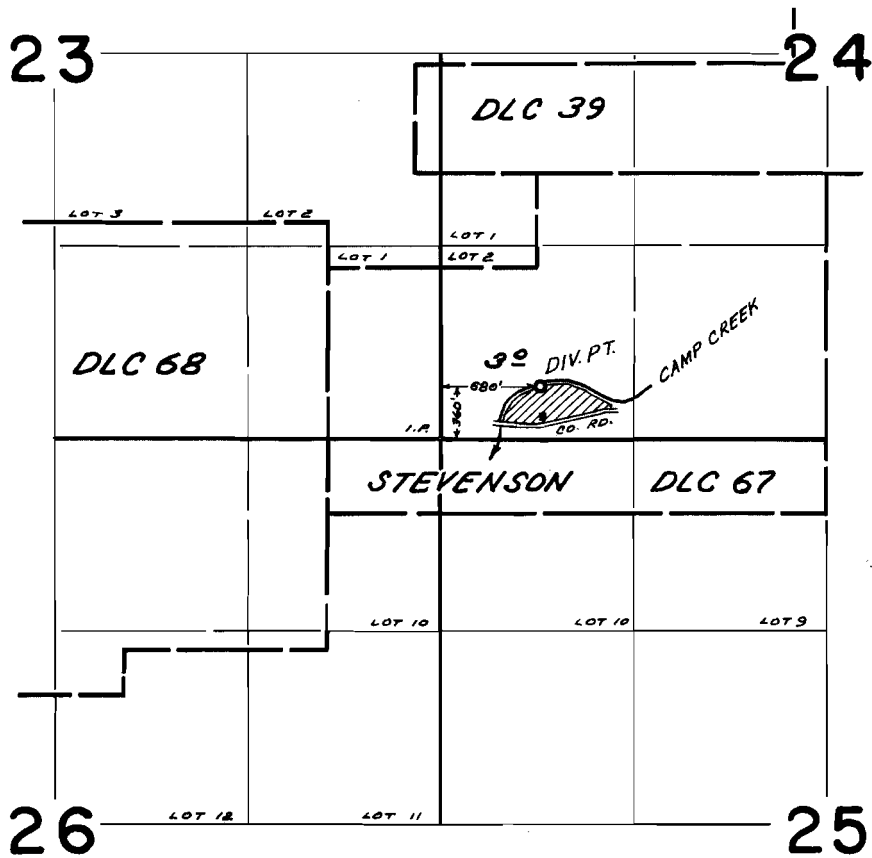

FINAL PROOF SURVEY
UNDER

Application No. 43943 Permit No. 32833
IN NAME OF

H. E. AND LOREE WOOLBRIGHT

Surveyed MAY 29 1969, by D. BUELL