


T.14 S. R.1 W. W.M.

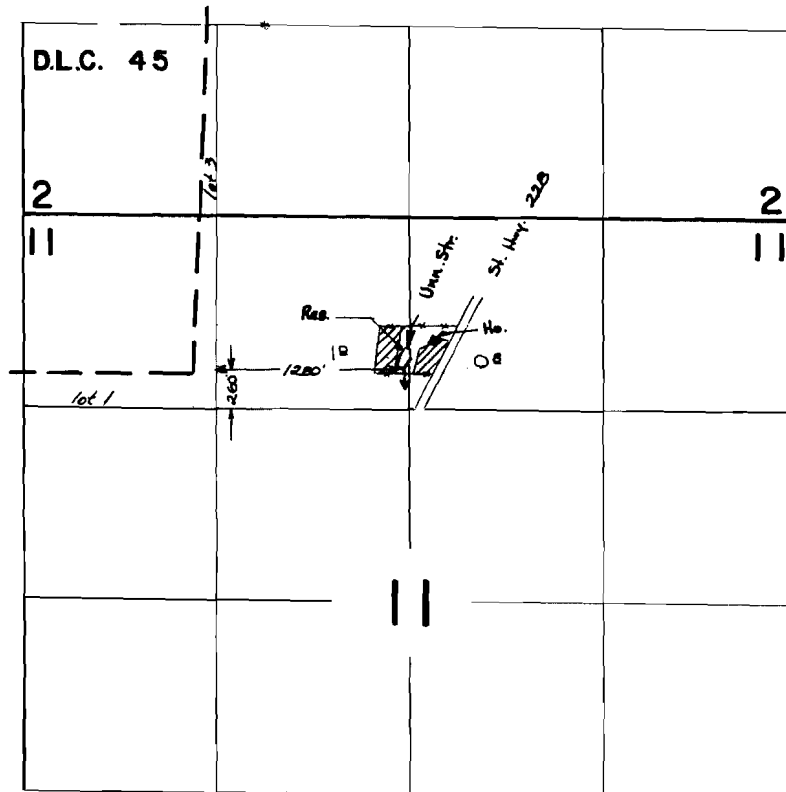

FINAL PROOF SURVEY
UNDER

R38264 R3209
Application No. 38265... Permit No. 28567...
IN NAME OF

DONALD LEMING

Surveyed 17 SEPT. 1969, by W. J. RUPPERT