


T.13S.R.1E.W.M.

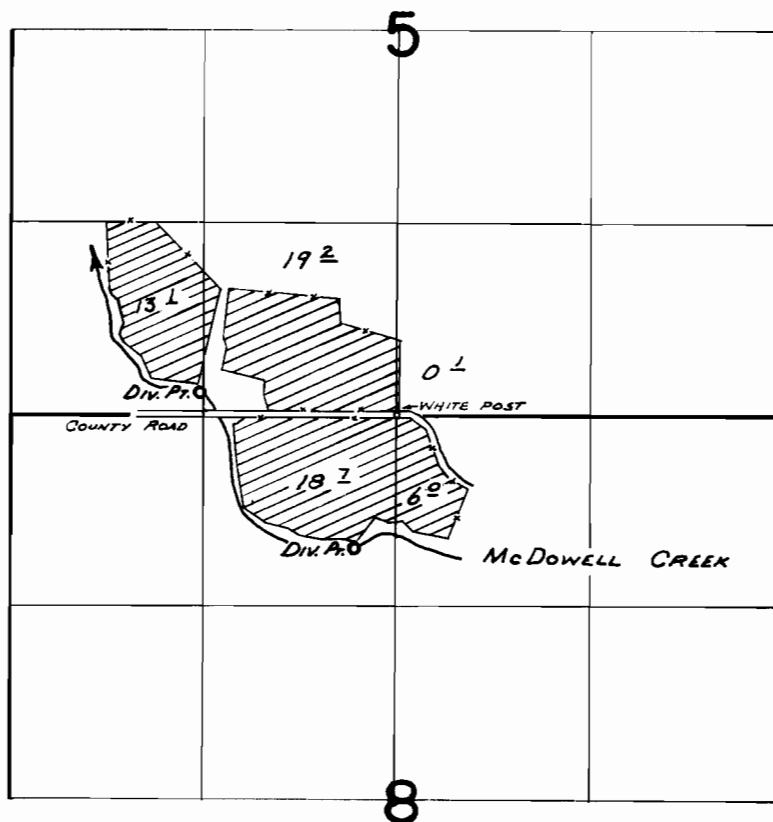

*Div. Pts. Located: 160' N. & 1340' W. ; 920' S. & 280' W
Both From 1/4 Cor. Sec. 518*

FINAL PROOF SURVEY
UNDER

Application No. 41149 Permit No. 30676
IN NAME OF

CLARENCE C. & ALBERTA C. BATES

Surveyed APR. 23, 1969, by W. RUPPERT