


T.7S.R.2W.W.M.

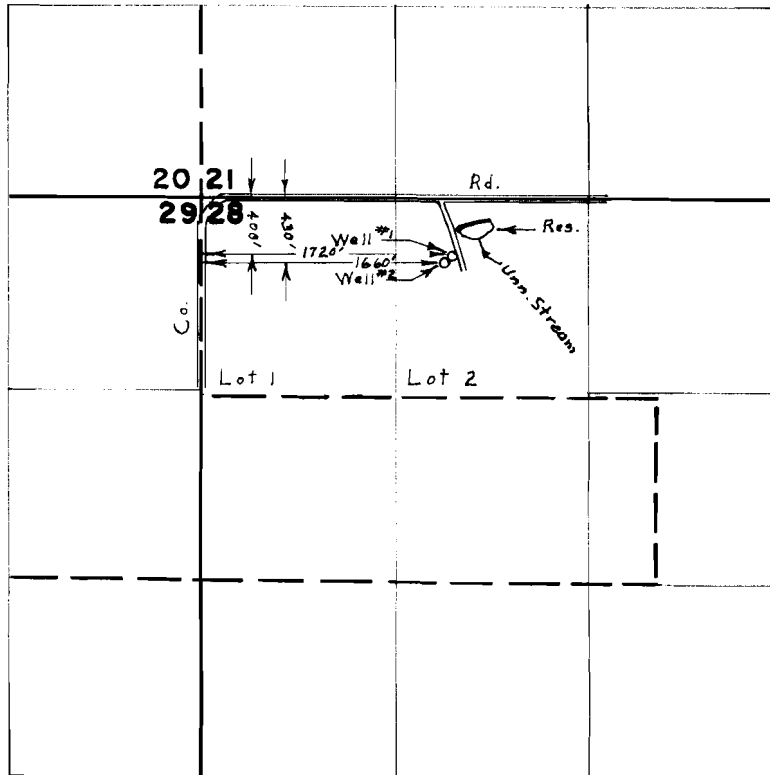

FINAL PROOF SURVEY
UNDER

Application No. **G-3258** **R-41529** Permit No. **G-3110** **R-4676**
IN NAME OF

BRUCE SQUIRE

Surveyed Aug. 17, 1966, by *L. E. Gould*
Insp. Mar. 23, 1970, by *D. Buell*