


T.7S.R.5W.W.M.

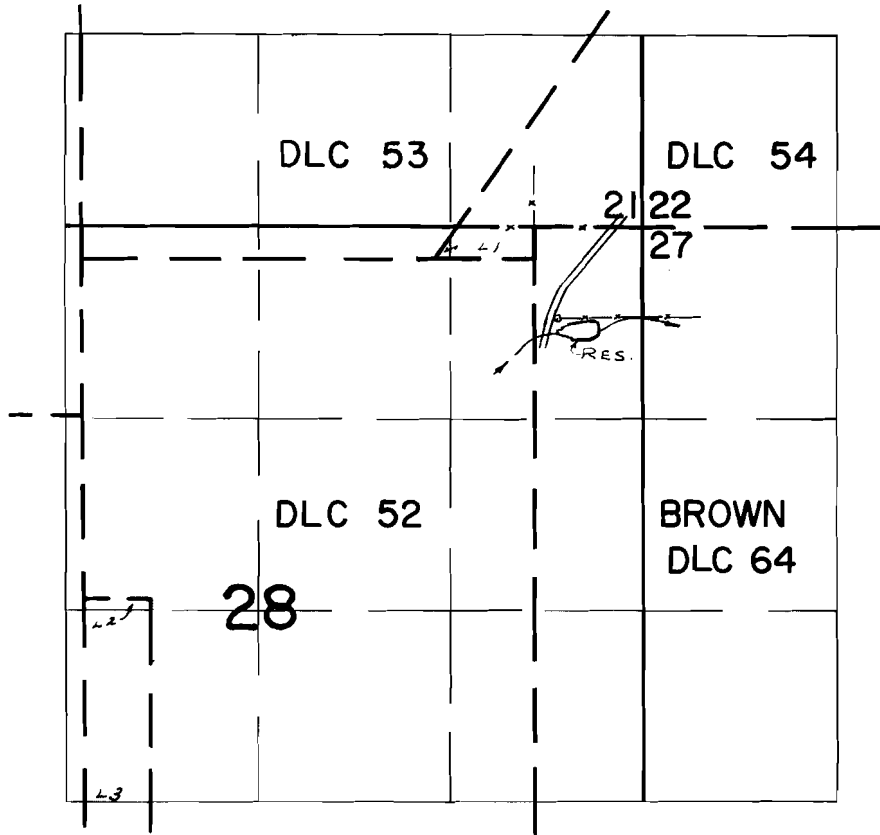

FINAL PROOF SURVEY
UNDER

Application No. R-41850 Permit No. R-4767
IN NAME OF

DAN K. FRIESEN

Surveyed AUG. 15, 1969, by D. BUELL