


T 8 S R 5 W. W. M.

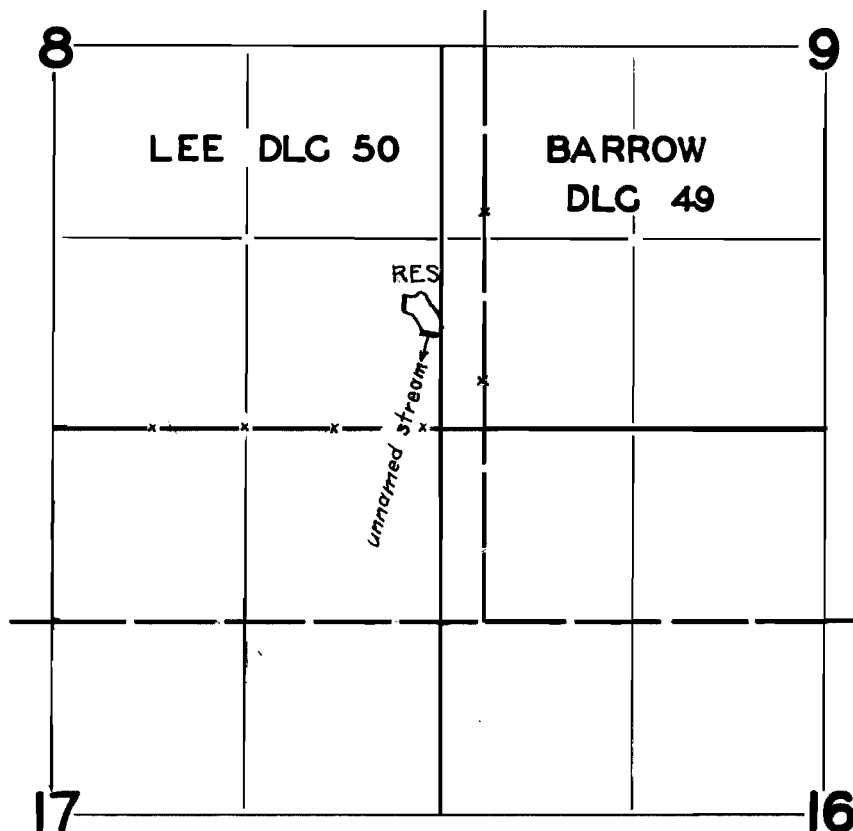

FINAL PROOF SURVEY UNDER

Application No. R-44524 Permit No. R-5272
IN NAME OF

DALE LIBOLT

Surveyed Mar. 28, 1969, by D. Buell