


T.7S.R.4W.W.M.

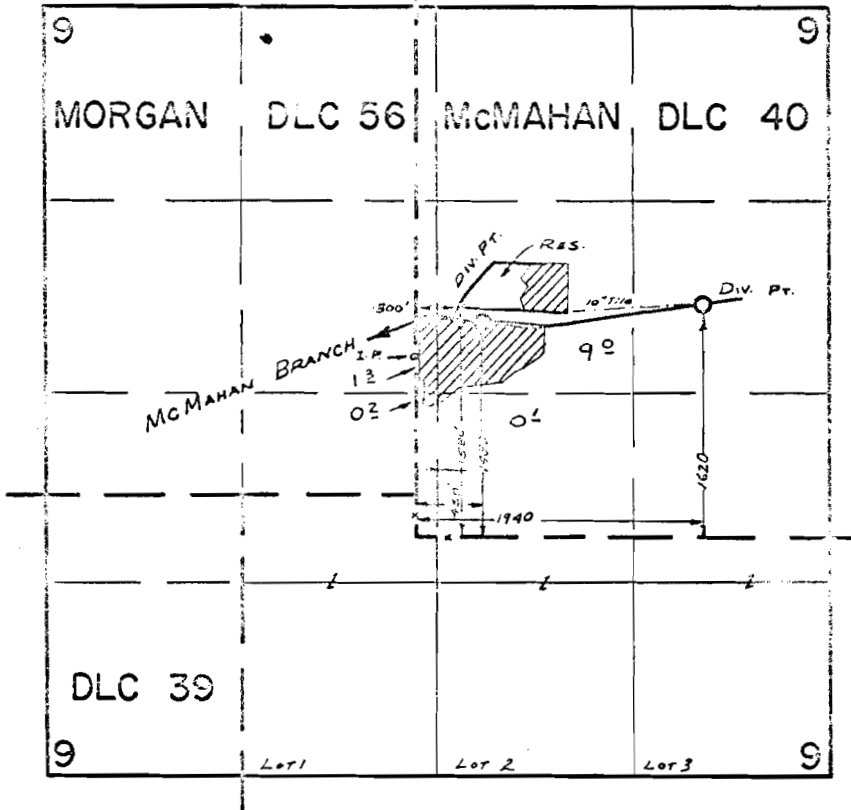

FINAL PROOF SURVEY
UNDER

Application No. ^{R-42444} 42445 Permit No. ^{R-4855} 31942
IN NAME OF

WILLIAM E. DOMES

Surveyed SEPT. 4, 1969, by D. BUELL