


T.7S.R.4W.W.M.

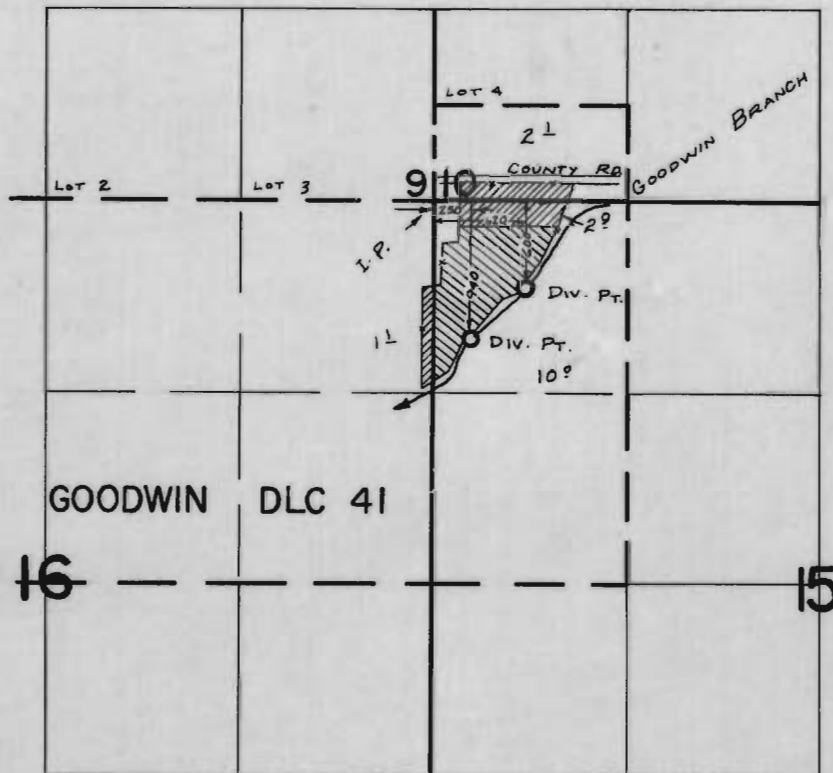

FINAL PROOF SURVEY UNDER

Application No. 47799 Permit No. 35809
41097 30612
IN NAME OF

WILLIAM E. DOMES

Surveyed SEPT. 3 1969, by D. BUELL
APRIL 24 1974 T. J. PAUL

