


# T.9S.R.5W.W.M.

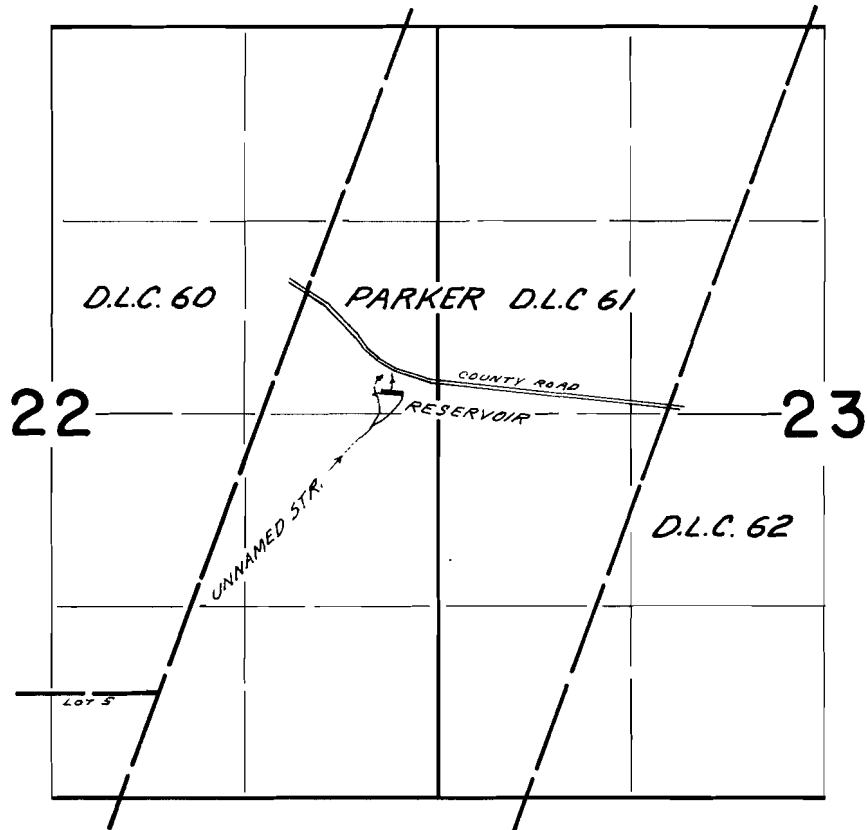

## FINAL PROOF SURVEY UNDER

Application No. R-43041 Permit No. R-4900  
IN NAME OF

STEPHEN BENEDICT

Surveyed MAR 25 1969, by D. BUELL