


# T. 9 S. R. 5 W. W.M.

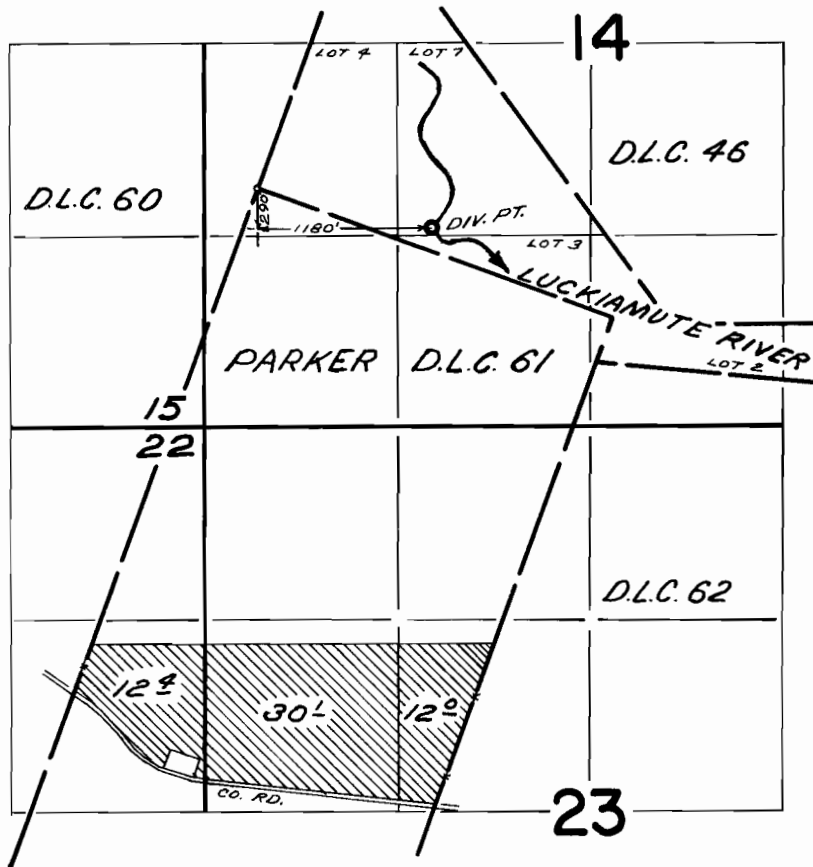

## FINAL PROOF SURVEY UNDER

Application No. 41793 Permit No. 31207  
IN NAME OF

STEPHEN BENEDICT

Surveyed MAR. 25 1989, by D. R. BUELL