


T. 9 S. R. 6 W. W.M.

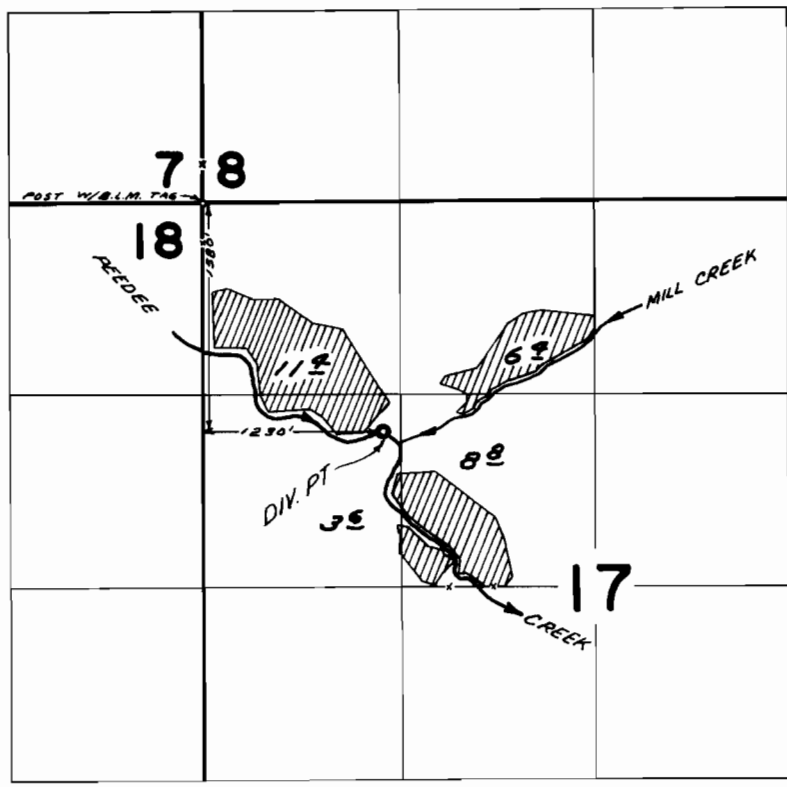

FINAL PROOF SURVEY UNDER

Application No. 37528 Permit No. 27967
IN NAME OF
ROBERT JAHN
Surveyed MAR. 24 1969, by D. BUELL