


T.7S.R.4W.W.M.

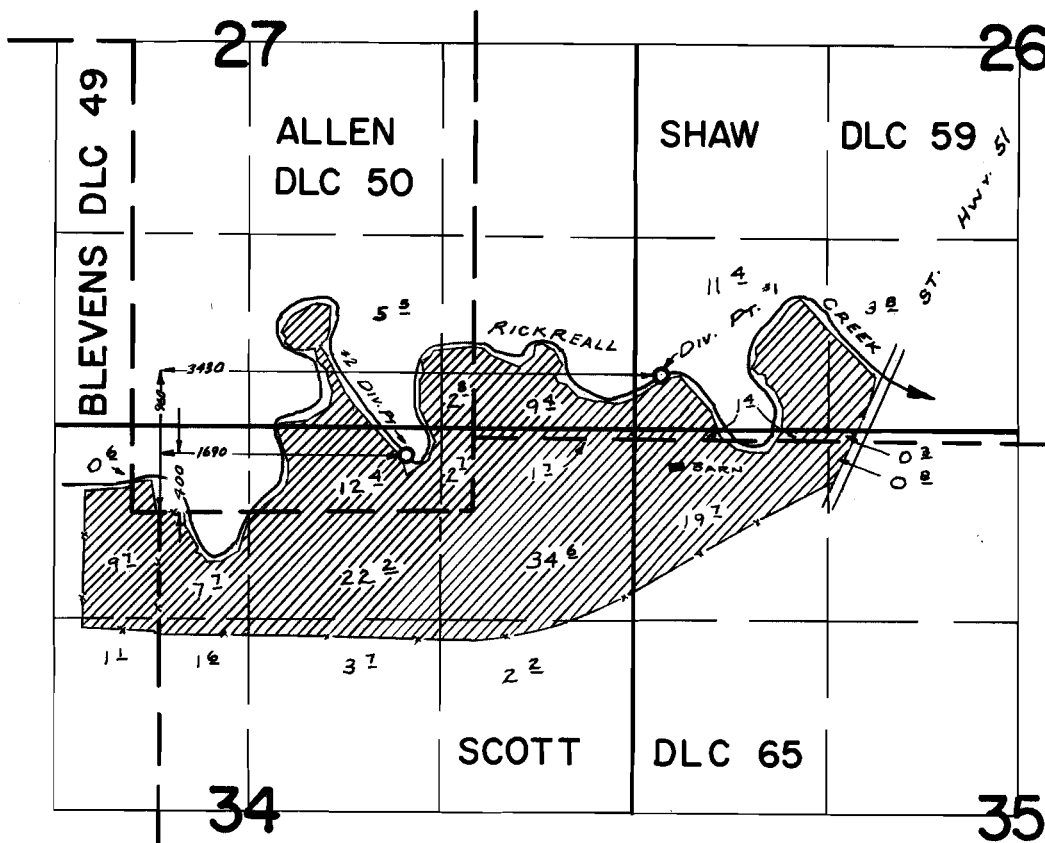

FINAL PROOF SURVEY UNDER

Application No. 39907 Permit No. 29776
IN NAME OF

J. G. & R. V. HOGG

Surveyed JULY 25, 1969, by D. BUELL