


# T.8S.R.6W.W.M.

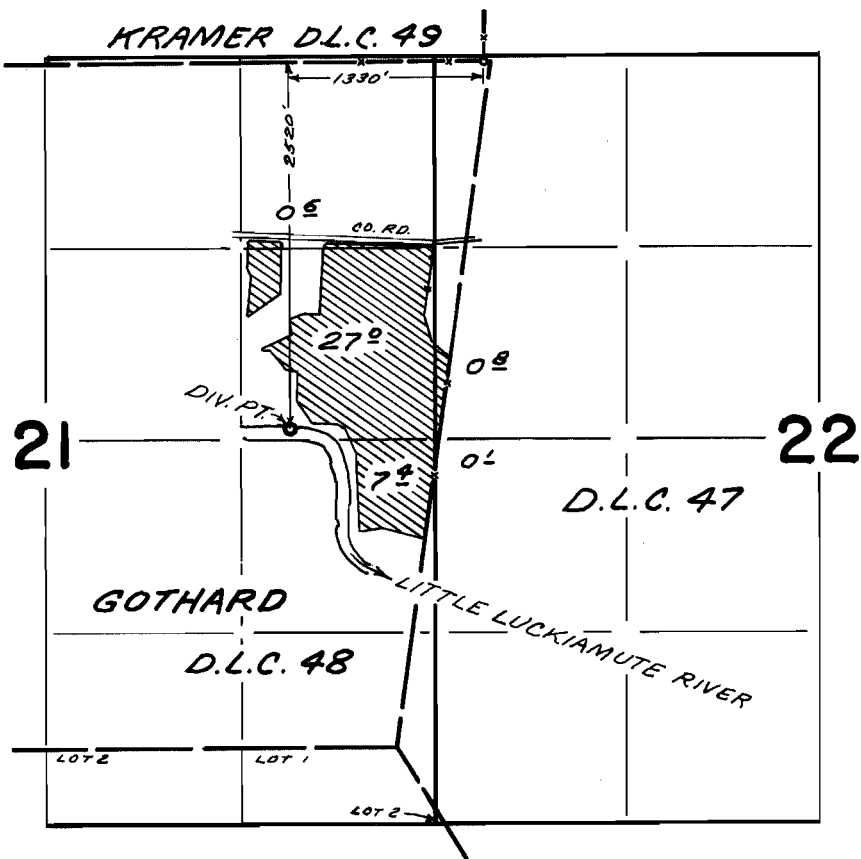

## FINAL PROOF SURVEY UNDER

Application No. 40666 Permit No. 30294  
IN NAME OF

CLAUDE M. CHAFFIN

Surveyed MAR. 27 1969, by D. BUELL