


# T.6S.R.5W.W.M.

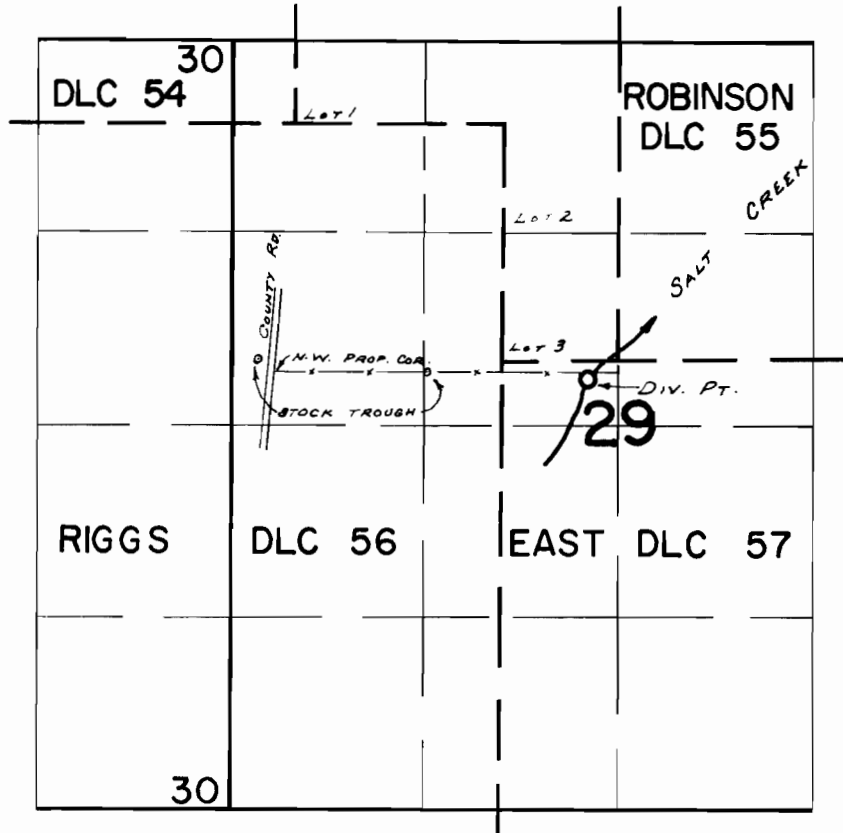

Div. Pt. Loc: 120'S & 210'W. FROM S.W. COR. ROBINSON DLC 55

## FINAL PROOF SURVEY UNDER

Application No. 41158 Permit No. 30683  
IN NAME OF

**MARVIN FAST**

Surveyed Oct. 6, 1969, by D. BUELL