


# T. 6S.R. 6W.W.M.

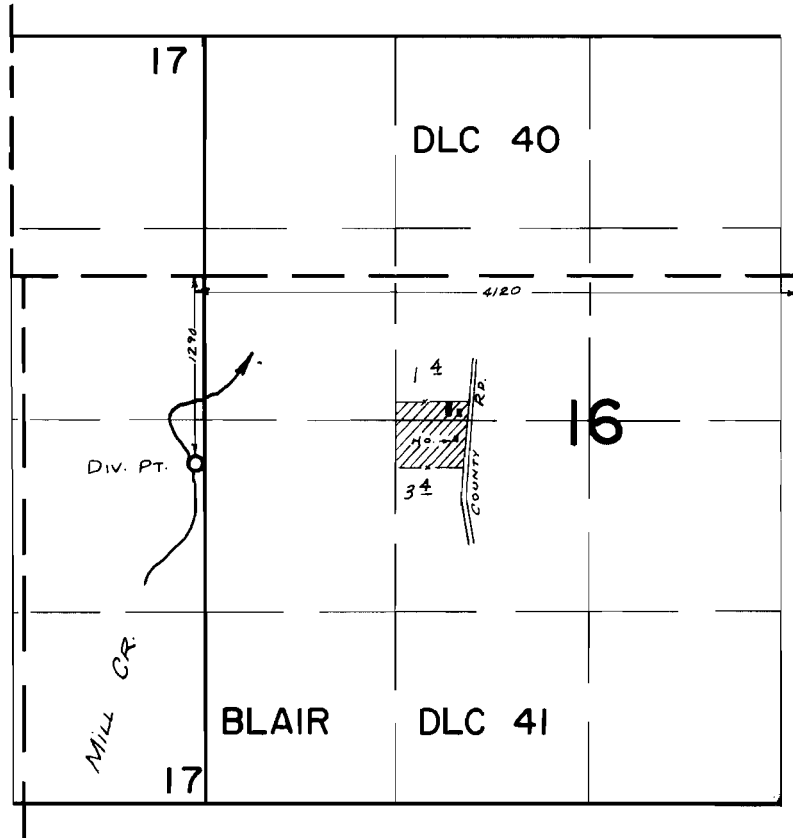

## FINAL PROOF SURVEY UNDER

Application No. 41990 Permit No. 31427  
IN NAME OF

*FRANK E. CROW*

Surveyed Oct. 7, 1969, by D. BULL